

LOWNDES

C 57

8-14-70

MISSISSIPPI BOARD OF WATER COMMISSIONERS 416 North State Street Jackson, Mississippi 39201

CODED

WATER WELL DRILLERS LOG

8-14 1970 W. J. REEVES & SON LOWNDES date well completed firm name county well located

LANDOWNER: C. E. FORTT 37 3/4 1/16

Rt. 6 PERKINS RD.

description of formations encountered

from

to

COVINGBOS

(mailing address)

CLAY 0 14 SAND & GRAVEL 14 26 BLUE SAND 26 37 CLAY 37 81 SAND 81 110

WELL LOCATION:

sec. 21 T-17 S R-18 E W 3 miles N. of COVINGBOS (distance) (direction) (nearest town)

WELL PURPOSE: HOME (home, irrigation, municipal, industrial)

WELL COMPLETION DATA:

- (1) diameter (inches) 4 (2) total depth (feet) 110 (3) static water level (feet) 9 below top of ground (4) casing STEEL 42' (material) (depth) 4 (size) If telescope see back. (5) screen NONE (length) (depth to top) (size) (material) (6) pump NONE (HP) (yield gpm) (type power) (7) electric log No (yes or no) (organization running log) (8) how well bottom plugged OPEN

CODED


NOV 25 1970

MISS. BD. OF WATER COMM.

DRILLERS REMARKS:

If well telescopes please sketch and show depths.

GROUND LEVEL

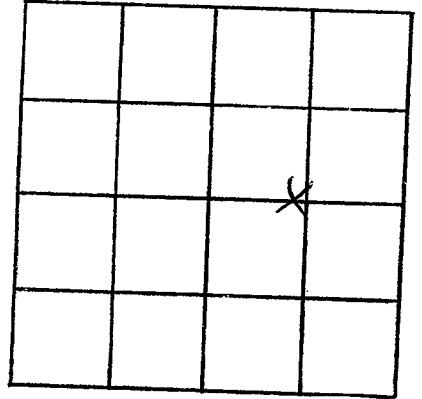

SECTION 21

Please indicate well location X.

ADDITIONAL INFORMATION

If more than one screen, show locations of each on sketch.