

LOWNDES
C58
8-20-70

MISSISSIPPI
BOARD OF WATER COMMISSIONERS
416 North State Street
Jackson, Mississippi 39201

CODED

WATER WELL DRILLERS LOG

8-20 1970 W. J. REEVES & SON LOWNDES
date well completed firm name county well located

LANDOWNER: SHELBY SHAW
4396401

description of formations encountered	from	to
CLAY	0	14
SAND & GRAVEL	14	26
BLUE CLAY	26	34
" SAND	34	39
" CLAY	39	55
" SAND	55	58
" CLAY	58	91
" SAND	91	97
" CLAY	97	122
" SAND	122	131
" CLAY	131	137
" SAND	137	157

RT. 6 A.B. RD.

COLUMBUS
(mailing address)

WELL LOCATION:

sec. 5 T. 17 S. R. 18 E. W.
6 miles NO. of COLUMBUS
(distance) (direction) (nearest town)

WELL PURPOSE: TRAILER PARK
(home, irrigation, municipal, industrial)

WELL COMPLETION DATA:

- (1) diameter (inches) 4
- (2) total depth (feet) 157
- (3) static water level (feet) 32 below above top of ground.
- (4) casing STEEL, 83
(material) (depth)
4 if telescope see back.
(size)
- (5) screen NONE
(length) (depth to top)
(size) (material)
- (6) pump 1, 30
(HP) (yield gpm)
ELECT
(type power)
- (7) electric log NO
(yes or no)
(organization running log)

CODED


- (8) how well bottom plugged OPEN

DRILLERS REMARKS:

NOV 25 1970
MISS. BU. OF WATER COMM.

If well telescopes please
sketch and show depths.

GROUND LEVEL

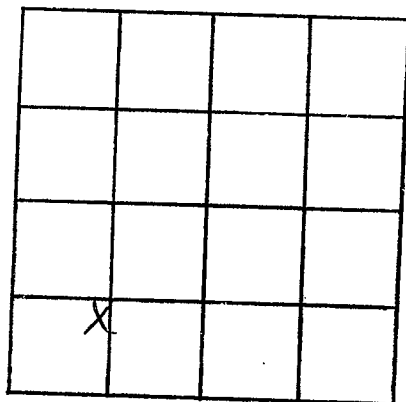

SECTION 5

Please indicate well location X.

ADDITIONAL INFORMATION

If more than one screen,
show locations of each on sketch.