

LOWNDES
 C 59
 9-17-70

MISSISSIPPI
 BOARD OF WATER COMMISSIONERS
 416 North State Street
 Jackson, Mississippi 39201

CODED

WATER WELL DRILLERS LOG

9-17-70 date well completed W. J. REEVES & SON firm name LOWNDES county well located

LANDOWNER: R. L. B. SCOW

description of formations encountered

from to

AMORY BARBER SHOP

CLAY	0	9
SAND & GRAVEL	9	24
BLUE CLAY	24	30
BLUE SAND + CLAY	30	54
CLAY	54	62
SAND	62	67
CLAY	67	94
SAND	94	101
CLAY	101	122
SAND	122	154

A. B. R. D. (mailing address)

WELL LOCATION:

sec. 5 T. 12 S. R. 18 W.
7 miles (distance) No. (direction) of COLUMBUS (nearest town)

WELL PURPOSE: INDUSTRIAL
 (home, irrigation, municipal, industrial)

WELL COMPLETION DATA:

- (1) diameter (inches) 4
- (2) total depth (feet) 154
- (3) static water level (feet) 27 below top of ground.
- (4) casing STEEL 82
 (material) (depth)
4 if telescope see back.
 (size)
- (5) screen NONE
 (length) (depth to top)
 (size) (material)
- (6) pump 1/2 6
 (HP) (yield gpm)
ELECT
 (type power)
- (7) electric log NO
 (yes or no)
 (organization running log)

CODED

NOV 25 1970


MISS. Bd. OF WATER

(8) how well bottom plugged OPEN

DRILLERS REMARKS:

If well telescopes please sketch and show depths.

GROUND LEVEL

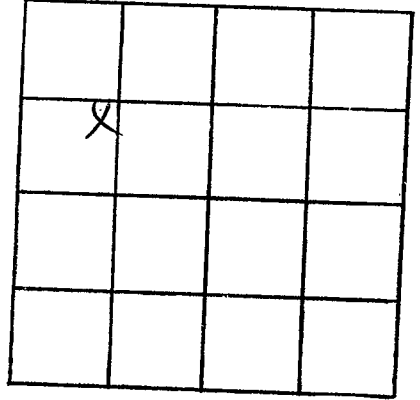

SECTION 5

Please indicate well location X.

ADDITIONAL INFORMATION

If more than one screen, show locations of each on sketch.