

LOWNDES
C 61
11-5-70

MISSISSIPPI
 BOARD OF WATER COMMISSIONERS
 416 North State Street
 Jackson, Mississippi 39201

CODED

WATER WELL DRILLERS LOG

11-5 1970 W. J. REEVES & SON LOWNDES
 date well completed firm name county well located

LANDOWNER: W. H. BELL JR.
3282052

RT. 5 DeWood DR.

COLUMBUS, Miss.
 (mailing address)

WELL LOCATION:

sec 29 T. 17 S. R. 18 W.

2 miles NW of COLUMBUS
 (distance) (direction) (nearest town)

WELL PURPOSE: HOME
 (home, irrigation, municipal, industrial)

WELL COMPLETION DATA:

(1) diameter (inches) 4

(2) total depth (feet) 175

(3) static water level (feet) 19 below
 top of ground: above

(4) casing STEEL 2 1/2
 (material) (depth)

4 if telescope see back.
 (size)

(5) screen NONE
 (length) (depth to top)

(size) (material)

(6) pump 1/2 8
 (HP) (yield gpm)

ELECT
 (type power)

(7) electric log NO
 (yes or no)

(organization running log)

(8) how well bottom plugged OPEN

description of formations encountered	from	to
CLAY	0	14
BLUE CLAY	14	132
" SAND	132	141
" CLAY	141	154
" SAND	154	175

CODED


MAR 16 1970

MISS. BD. OF
 WATER COMMISSIONERS

DRILLERS REMARKS:

If well telescopes please
sketch and show depths.

GROUND LEVEL

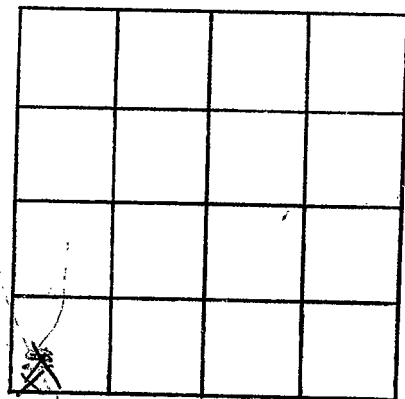

SECTION 29

Please indicate well location X.

ADDITIONAL INFORMATION

If more than one screen,
show locations of each on sketch.