

C63

7-19-62

WATER WELL DRILLERS LOG

CODED

Date: 7-19, 1962, Driller: J.C. REEVES County LOWNDES

10167

(Name)

(1) Owner of Land: P.W. PARTAIN

(Name)

COLUMBUS, MISS

(Address)

(2) Location: 1/4, 1/4, Sec. 32 T17R18E

3 miles NORTH of Columbus (distance) (direction) (Nearest Town)

(3) Topography: FLAT (Hilly) (Flat) (Level)

(4) Purpose of Well: DOMESTIC (Domestic Irrigation Municipal, Industrial, Other)

Description & Color of Materials Sand, Clay, Red Clay, Shell, etc.	Thick- ness Feet	Depth Feet
CLAY	9	0
SAND & GRAVEL	18	9
BLUE CLAY	71	27
" SAND	7	98
" CLAY	28	106
" SAND	13	133
" CLAY	11	146
" SAND	16	157
" CLAY	5	173

Information upon completion of well:

(1) Diameter: 4 inches.

(2) Total Depth: 178 feet.

(3) Water Level: 10 feet below top of ground.

(4) Cased to: 31', Size: 4"

(5) Screen: Size: —, Length: —


(6) Were any formations sealed against pollution? yes, no.

If YES depth of formation: —

Why: —


Drillers Remarks: —

CODED

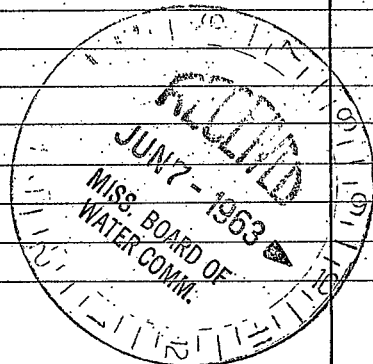

(Use Back Side)

Well No.

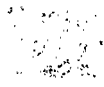

Handwritten text at the top of the page, possibly a title or header.

Main body of handwritten text, appearing as a list or series of entries. The text is very faint and difficult to read, but seems to be organized in a structured manner.