

LOWNDES
C 65
1-13-61

MISSISSIPPI BOARD OF WATER COMMISSIONERS

WATER WELL DRILLERS LOG

CODED

Date: 1-13, 1961, Driller: W.J. REEVES & SON County, LOWNDES

(Name)

10279

- (1) Owner of Land: JAMES REEVES
H W 95 N, 328 & 335 (Name)
COLUM BUS, MISS
(Address)
- (2) Location: NE NW NW
1/4, 1/4, Sec. 33 T7 R6 N
3 miles N, of COLUMBUS
(distance) (direction) (Nearest Town)
- (3) Topography: HILLY
(Hilly) (Flat) (Level)
- (4) Purpose of Well: DOMESTIC
(Domestic Irrigation
Municipal, Industrial, Other)

Description & Color of Materials Sand, Clay, Red Clay, Shell, etc.	Thick- ness Feet	Depth Feet
SANDY CLAY	16	0
BLUE SANDY CLAY	79	16
BLUE CLAY	35	95
BLUESAND-CLAY STRKS.	35	120
BLUE CLAY-SAND STRKS.	44	155

CODED


Information upon completion of well:

- (1) Diameter 4 inches.
- (2) Total Depth 199 feet:
- (3) Water Level 60 feet below top of ground.
- (4) Cased to 106, Size 4
- (5) Screen: Size _____, Length _____
- (6) Were any formations sealed against pollution?
_____ yes, _____ no.

If YES depth of formation _____

Why _____

Drillers Remarks: _____

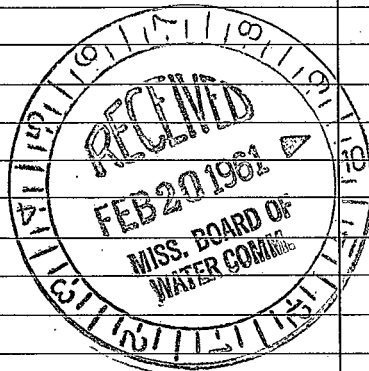

(Use Back Side)

Well No.

Mail this copy to Board of Water Commissioners 429 Miss. St. Jackson, Miss

