

LOWNOES

C70

CODED

WATER WELL DRILLERS LOG

8-12-61

Date: 8-12, 1961, Driller: J.C. REEVES County: LOWNOES

9566 9625

(Name)

(1) Owner of Land: J.B. HUMBER (Name)

Columbus, Miss (Address)

HW 45N 3866018

(2) Location: NE 1/4, NW 1/4, Sec. 10 T17R18W

6 miles N of COLUMBUS (distance) (direction) (Nearest Town)

(3) Topography: FLAT (Hilly) (Flat) (Level)

(4) Purpose of Well: DOM (Domestic Irrigation Municipal, Industrial, Other)

Description & Color of Materials Sand, Clay, Red Clay, Shell, etc.	Thick- ness Feet	Depth Feet
CLAY	12	0
SAND & GRAVEL	14	12
BLUE CLAY	14	26
" SAND	6	40
" CLAY	7	46
" SAND	15	53

CODED

Information upon completion of well:

(1) Diameter: 4 inches.

(2) Total Depth: 68 feet.

(3) Water Level: 7 feet below top of ground.

(4) Cased to: 29 1/2', Size: 4"

(5) Screen: Size _____, Length _____


(6) Were any formations sealed against pollution?

yes, no.

If YES depth of formation _____

Why _____

Drillers Remarks: _____

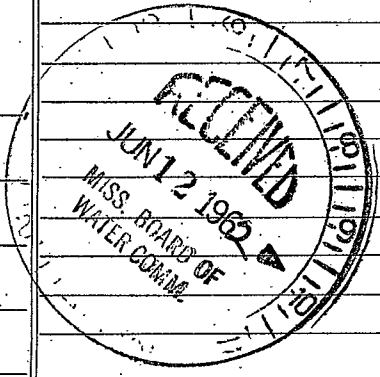

(Use Back Side)

Well No.

1. The first part of the document discusses the importance of maintaining accurate records of all transactions. It emphasizes that every entry should be supported by a valid receipt or invoice to ensure transparency and accountability.

2. In the second section, the author outlines the various methods used for data collection and analysis. This includes both primary and secondary research techniques, as well as the use of statistical software to process large datasets.

3. The third section provides a detailed overview of the findings from the study. It highlights several key trends and patterns observed in the data, which are discussed in the context of the research objectives.

4. Finally, the document concludes with a series of recommendations for future research and practical applications. These suggestions are based on the insights gained from the current study and aim to address the limitations identified.