

LOWNDES

C-71

MISSISSIPPI BOARD OF WATER COMMISSIONERS

5-24-66

WATER WELL DRILLERS LOG

CODED

Date: 5-24, 1966, Driller: J. C. REEVES County: LOWNDES

(When well drilled)

16797

(Name)

(Where well is located)

(1) Owner of Land: ^{changed} MARVIN CORBIEL

SPIVEY RD, 3207010 (Name)

STAR RT, COLUMBUS

(Address)

(2) Location: SW SE 1/4, Sec. 5, T17S R18W

8 miles N of COLUMBUS (distance) (direction) (Nearest Town)

(3) Topography: FLAT (Hilly) (Flat) (Level)

(4) Purpose of Well: DOMESTIC (Domestic Irrigation, Municipal, Industrial, Other)

Description & Color of Materials Sand, Clay, Red Clay, Shell, etc.	Thick- ness Feet	Depth Feet
CLAY	6	
SAND & GRAVEL	22	6
BLUE CLAY	17	28
" SAND	18	45
" CLAY	27	63
" SAND	25	90

Information upon completion of well:

(1) Diameter 4 inches.

(2) Total Depth 115 feet.

(3) Water Level 20 feet below top of ground.

(4) Cased to 31', Size 6"

(5) Screen: Size —, Length —

(6) Were any formations sealed against pollution? yes, no.

If YES depth of formation

Why


Drillers Remarks:

Yield in gpm: 25 - AIR

Size pump: 1/3 H.P. JET

Type power: ELECTRIC

CODED

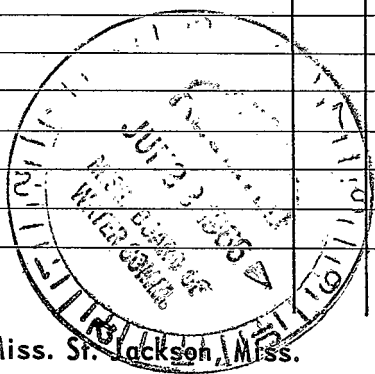

[The page contains extremely faint and illegible text, likely bleed-through from the reverse side of the document. The text is arranged in several vertical columns and is mostly unreadable.]