

Lowndes
C73
5-67

MISSISSIPPI
 BOARD OF WATER COMMISSIONERS
 416 North State Street
 Jackson, Mississippi 39201

CODED

WATER WELL DRILLERS LOG

5-18 1967 W.J. REEVES & SON LOWNDES
 date well completed firm name county well located

LANDOWNER: DARR NICHOLSON

description of formations encountered	from	to
SANDY CLAY	0	8
SAND & GRAVEL	8	24
BLUE CLAY	24	48
" SAND	48	53
" CLAY	53	62
" SAND	62	67
" CLAY & SAND	67	78
" CLAY	78	94
" SAND	94	106
" CLAY	106	116
" SAND	116	124
" CLAY	124	132
" SAND	132	155
" CLAY	155	158

RT. 5

COLUMBUS
 (mailing address)


WELL LOCATION:
 sec. 5 T. 17 S. R. 18 E.
8 miles N of COLUMBUS
 (distance) (direction) (nearest town)

WELL PURPOSE: TRAVEL PARK
 (home, irrigation, municipal, industrial)

WELL COMPLETION DATA:

- (1) diameter (inches) 4
- (2) total depth (feet) 158
- (3) static water level (feet) 19 below top of ground.
- (4) casing STEEL, 33,
 (material) (depth)
4 if telescope see back.
 (size)
- (5) screen NONE
 (length) (depth to top)
 (size) (material)
- (6) pump I 20
 (HP) (yield gpm)
ELECT
 (type power)
- (7) electric log NO
 (yes or no)
 (organization running log)
- (8) how well bottom plugged OPEN


CODED

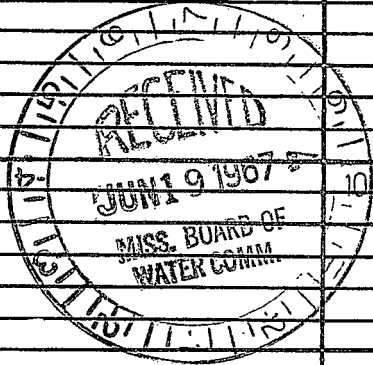

DRILLERS REMARKS:

If well telescopes please sketch and show depths.

GROUND LEVEL

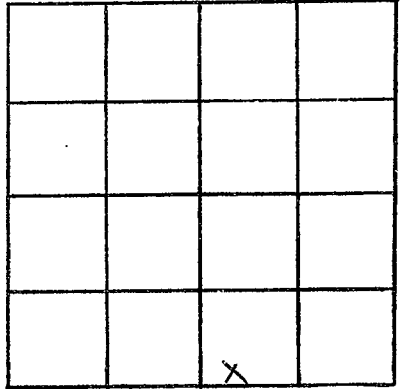

SECTION _____

Please indicate well location X.

ADDITIONAL INFORMATION

If more than one screen, show locations of each on sketch.