

Louise
C-75
6-66

MISSISSIPPI BOARD OF WATER COMMISSIONERS

WATER WELL DRILLERS LOG

CODED

Date: June, 1966, Driller: W. B. Clardy County Louise
(Name)

BILL WRIGHT
(1) Owner of Land: Airbase Trailer Sales
(Name) 4396712
(Address)

(2) Location: NW 1/4, NW 1/4, Sec. 5 T R
12 miles N 175 18 N of Colo.
(distance) (direction) (Nearest Town)

(3) Topography: Flat
(Hilly) (Flat) (Level)

(4) Purpose of Well: _____
(Domestic Irrigation
Municipal, Industrial, Other)

Description & Color of Materials Sand, Clay, Red Clay, Shell, etc.	Thick- ness Feet	Depth Feet
<u>Sand + gravel</u>	<u>8'</u>	<u>29'</u>
<u>Blue Clay and sandy streaks</u>	<u>29'</u>	<u>82'</u>
<u>Blue rock</u>	<u>82'</u>	<u>150'</u>
<u>Sand</u>	<u>150'</u>	<u>170'</u>


Information upon completion of well:

- (1) Diameter 4 inches.
- (2) Total Depth 170 feet.
- (3) Water level 12 feet below top of ground.
- (4) Cased to 86', Size 4"
- (5) Screen: Size _____, Length _____
- (6) Were any formations sealed against pollution?
_____ yes, _____ no.

If YES depth of formation _____
Why _____

Drillers Remarks: _____

CODED

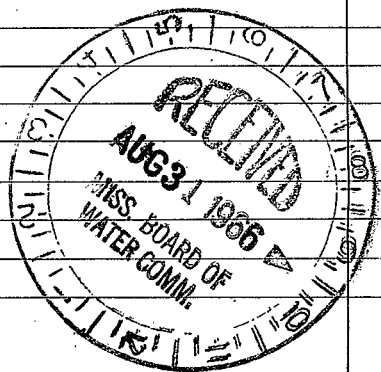

(Use Back Side)

Well No.

