

C76

7-5-62

WATER WELL DRILLERS LOG

CODED

Date: 7-5, 1962, Driller: J.C. [Signature] County: Lowndes

WILLYS STOP SHOP

(Name)

(1) 4349602 Owner of Land: FORTNER GROCERY

(Name)

107 Air Base Rd, Columbus Miss

(Address)

NE SW NW

(2) Location: 1/4, 1/4, Sec. 5 T17S R18W

8 miles N, of COLUMBUS, (distance) (direction) (Nearest Town)

(3) Topography: LEVEL (Hilly) (Flat) (Level)

(4) Purpose of Well: DOM. (Domestic Irrigation Municipal, Industrial, Other)

| Description & Color of Materials Sand, Clay, Red Clay, Shell, etc. | Thick- ness Feet | Depth Feet |
|---|------------------------|---------------|
| CLAY | 8 | 0 |
| SAND & GRAVEL | 9 | 8 |
| BLUE CLAY | 6 | 17 |
| BLUE SAND (SOFT) | 7 | 23 |
| BLUE CLAY | 56 | 30 |
| " SAND | 5 | 86 |
| " CLAY | 32 | 91 |
| " SAND | 9 | 123 |
| " CLAY | 3 | 132 |
| " SAND | 7 | 135 |
| " CLAY | 6 | 142 |
| " SAND | 9 | 148 |
| 1- CLAY | 3 | 151 |

Information upon completion of well:

(1) Diameter: 4 inches.

(2) Total Depth: 160 feet.

(3) Water Level: 20 feet below top of ground.

(4) Cased to: 33', Size: 4"

(5) Screen: Size: —, Length: —

(6) Were any formations sealed against pollution?


yes, no.

If YES depth of formation: —

Why: —

Drillers Remarks: —

CODED

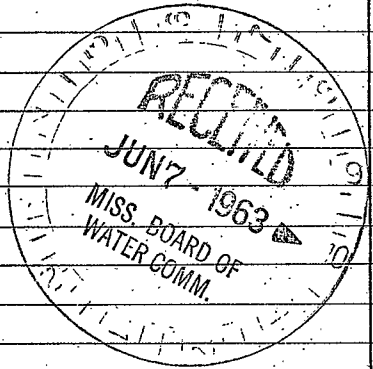

(Use Back Side)

Well No.

[The page contains extremely faint and illegible text, likely bleed-through from the reverse side of the document. The text is too light to transcribe accurately.]