

C305

ACT 77
4-14-61

WATER WELL DRILLERS LOG

CODED

Date: 4-14, 1961, Driller: W. J. REEVES & SON County LOWNDES

11641

(Name)

(1) Owner of Land: ROBE THOMPSON
(Name)
AIR BASE RD., COLUMBUS
(Address)

(2) Location: NW 1/4, NW 1/4, Sec. 5 175 120
31 TIBERTON
8 miles NORTH of COLUMBUS
(distance) (direction) (Nearest Town)

(3) Topography: LEVEL
(Hilly) (Flat) (Level)

(4) Purpose of Well: DOMESTIC
(Domestic Irrigation
Municipal, Industrial, Other)

Description & Color of Materials Sand, Clay, Red Clay, Shell, etc.	Thick- ness Feet	Depth Feet
RED CLAY	17	0
SAND & GRAVEL	17	17
BLUE CLAY	53	34
" SAND	6	87
" CLAY	18	93
" SAND	11	111
" CLAY	9	122
" SAND	24	131

Information upon completion of well:

(1) Diameter 4 inches.

(2) Total Depth 155 feet.
1-27-72 31.7'

(3) Water Level 20 feet (below) top of ground.

(4) Cased to 37 1/2', Size 4"

(5) Screen: Size _____, Length _____


(6) Were any formations sealed against pollution?
_____ yes, _____ no.

If YES depth of formation _____

Why _____

Drillers Remarks: _____

CODED

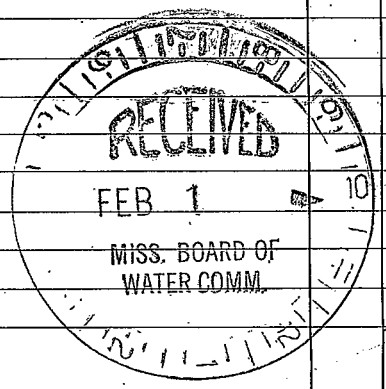

(Use Back Side)

Well No.

35

2.20

81.00