

2304

ACT 79

8-30-60

WATER WELL DRILLERS LOG

**CODED**

Date: 8-30, 19 60, Driller: W. J. REEVES & SONS County LOWNDES

9399 9437 10660

(Name)

(1) Owner of Land: JAMES BLENN  
STRENS RD, A.B. RD (Name)

327 2328 COLUMBUS, MISS  
(Address)

(2) Location: SE NW NW 3 18 170  
5 T 18 R 18 W  
1/4, 1/4, Sec. 5

8 miles N, of COLUMBUS  
(distance) (direction) (Nearest Town)

(3) Topography: LEVEL  
(Hilly) (Flat) (Level)

(4) Purpose of Well: DOMESTIC  
(Domestic Irrigation  
Municipal, Industrial, Other)

Description & Color of Materials Sand, Clay, Red Clay, Shell, etc.	Thick- ness Feet	Depth Feet
CLAY	9	0
SAND & GRAVEL	14	9
ROUE CLAY	29	23
" SAND	11	52
" CLAY	43	63
" SAND	29	106

**CODED**

Information upon completion of well:

(1) Diameter 4 inches.

(2) Total Depth 135 feet.

(3) Water Level 15 feet below top of ground.

(4) Cased to 25, Size 4

(5) Screen: Size \_\_\_\_\_, Length \_\_\_\_\_


(6) Were any formations sealed against pollution?

\_\_\_\_\_ yes, \_\_\_\_\_ no.

If YES depth of formation \_\_\_\_\_

Why \_\_\_\_\_

Drillers Remarks: \_\_\_\_\_

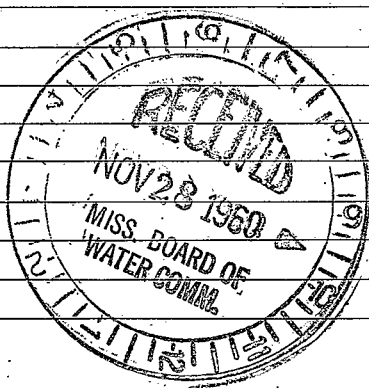

(Use Back Side)

Well No.

1942

[The body of the document contains several paragraphs of text that are extremely faint and illegible due to the quality of the scan. The text appears to be organized into sections, possibly separated by horizontal lines, but the specific content cannot be discerned.]