

LOWNDES

C80

MISSISSIPPI BOARD OF WATER COMMISSIONERS

5-30-66

WATER WELL DRILLERS LOG

CODED

Date: 5-30, 1966, Driller: J.C. REEVES County LOWNDES

(When well drilled) 9447 9698

(Name)

(Where well is located)

(1) Owner of Land: W. J. SANFORD JR. (Name) 434835

AIR BASE RD., COLUMBUS (Address)

(2) Location: NENE NW 17 1/4, Sec. 8 T17R18W

6 miles N of COLUMBUS (distance) (direction) (Nearest Town)

(3) Topography: LEVEL (Hilly) (Flat) (Level)

(4) Purpose of Well: DOMESTIC (Domestic Irrigation Municipal, Industrial, Other)

| Description & Color of Materials<br>Sand, Clay, Red Clay, Shell, etc. | Thick-<br>ness<br>Feet | Depth<br>Feet |
|---|------------------------|---------------|
| RED CLAY  | 16                     |               |
| RED SAND  | 6                      | 16            |
| SAND & GRAVEL   | 11                     | 22            |
| BLUE CLAY   | 5                      | 33            |
| BLUE SAND   | 7                      | 38            |
| BLUE CLAY   | 18                     | 45            |
| " SAND  | 11                     | 63            |
| " CLAY  | 30                     | 74            |
| " SAND  | 31                     | 104           |

Information upon completion of well:

(1) Diameter 4 inches.

(2) Total Depth 135 feet.

(3) Water Level 25 feet below top of ground.

(4) Cased to 55', Size 4"

(5) Screen: Size —, Length —.

(6) Were any formations sealed against pollution?

— yes, — no.

If YES depth of formation —.

Why —.


Drillers Remarks: —.

Yield in gpm: 30 AIR COMP.

Size pump: NOT FURNISHED

Type power: —.

CODED

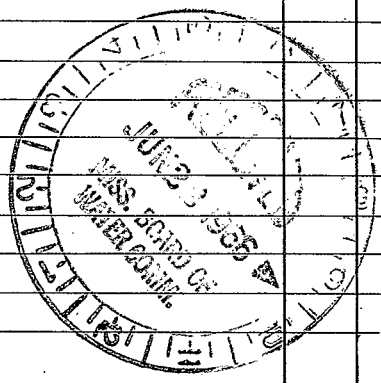

[The page contains extremely faint and illegible text, likely bleed-through from the reverse side of the document. The text is too light to transcribe accurately.]