

LOWNDES

C 81

7-22-60

WATER WELL DRILLERS

CODED

G300

Date: July 22, 1960, Driller: W. B. Clardy County Louisa

10150 16523 3RD HONR. (Name Post Office) int. rd.

L.I.O. Scales

(1) Owner of Land: C. G. Campbell
(Name)

Hwy 455 3284770
(Address)

(2) Location: NW NE SE 35 19 17E
1/4, 1/4, 1/4 Sec. (32) T12R18W

1/2 miles no. of Columbus
(distance) (direction) (Nearest Town)

(3) Topography: X
(Hilly) (Flat) (Level)

(4) Purpose of Well: Domestic
(Domestic Irrigation Municipal, Industrial, Other)

Description & Color of Materials Sand, Clay, Red Clay, Shell, etc.	Thickness Feet	Depth Feet
<u>Sandy point Clay</u>		<u>to 15'</u>
<u>Blue Clay</u>		<u>- 15' to 53'</u>
<u>rock</u>		<u>- 53'</u>
<u>Clay</u>		<u>- 53' to 100'</u>
<u>rock</u>		<u>- 100'</u>
<u>strips of rock and</u>		
<u>Blue Clay</u>		<u>to 150'</u>
<u>Sand</u>		<u>- 150' to 155'</u>
<u>Clay</u>		<u>- 155' to 185'</u>
<u>Sand</u>		<u>- 185' to 190'</u>
<u>strips of rock and</u>		
<u>sand</u>		<u>to 280'</u>
<u>Sand</u>		<u>- 280' to 330'</u>

Information upon completion of well:

(1) Diameter 4 inches.

(2) Total Depth 330 feet.


(3) Water Level 50 feet below top of ground.

(4) Cased to 64'-10" Size 4"

(5) Screen: Size _____, Length _____

(6) Were any formations sealed against pollution?
_____ yes, _____ no.

CODED

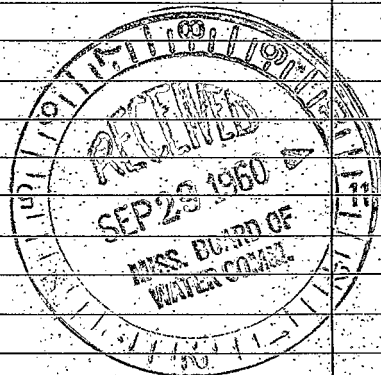

Well No. G300

(Use Back Side)

