

LOWNDES

C 84

5-12-66

MISSISSIPPI BOARD OF WATER COMMISSIONERS

WATER WELL DRILLERS LOG

CODED

Date: 5-12, 1966, Driller: J.C. REEVES County LOWNDES

(When well drilled)

16730

(Name)

(Where well is located)

(1) Owner of Land: Wm. D. LAND (Name) 3287206

RIDGE RD., COLUMBUS (Address)

(2) Location: W NE SE 1/4, 1/4, Sec. 27 T17R180

6 miles N of COLUMBUS (distance) (direction) (Nearest Town)

(3) Topography: HILLY (Hilly) (Flat) (Level)

(4) Purpose of Well: DOMESTIC (Domestic Irrigation Municipal, Industrial, Other)

Description & Color of Materials Sand, Clay, Red Clay, Shell, etc.	Thick-ness Feet	Depth Feet
RED SANDY CLAY	16	
RED SAND	60	16
BLUE SAND	11	76
" CLAY	4	80
" SAND	6	91
" CLAY	17	97
" SAND	5	114
" CLAY	5	119
BLUE SANDY CLAY	11	124
BLUE SAND & SHALE	55	135
" CLAY	20	190
" SAND	4	210
" CLAY	6	214

Information upon completion of well:

(1) Diameter 4 inches.

(2) Total Depth 220 feet.

(3) Water Level 68 feet below top of ground.

(4) Cased to 121', Size 4"

(5) Screen: Size —, Length —

(6) Were any formations sealed against pollution? — yes, — no.

If YES depth of formation

Why


Drillers Remarks:

Yield in gpm: 25 - AIR

Size pump: 3/4 HP SUB-100 PM

Type power: ELECTRIC

CODED

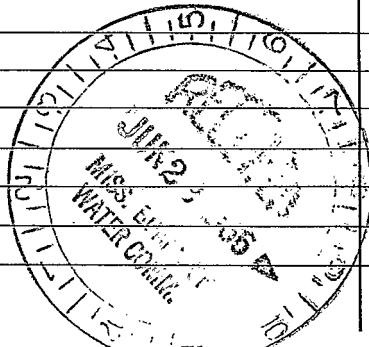

[The page contains extremely faint and illegible text, likely bleed-through from the reverse side of the document. The text is too light to transcribe accurately.]