

LOWNDES

MISSISSIPPI BOARD OF WATER COMMISSIONERS

C90

1-1-63

WATER WELL DRILLERS LOG

CODED

Date: 1/1, 1963, Driller: W.B. Clardy County Lowndes

11707

(Name)

(1) Owner of Land: Billy Crossley (Name)

(Address)

(2) Location: NW SW SW 1/4, Sec. 15 T. 12R. 17W

3 miles N.W. of Coln. (distance) (direction) (Nearest Town)

(3) Topography: Flat (Hilly) (Flat) (Level)

(4) Purpose of Well: Domestic (Domestic Irrigation Municipal, Industrial, Other)

Description & Color of Materials Sand, Clay, Red Clay, Shell, etc.	Thick- ness Feet	Dept Feet
Sand + Gravel	8"	25'
Blue Clay	25"	
Sand	60' to 65'	
Blue clay	65' to 90'	
Sand	90' to 105'	

Information upon completion of well:

- (1) Diameter 4 inches.
- (2) Total Depth 105' feet.
- (3) Water Level 5.2' feet below top of ground.
- (4) Cased to 42', Size 4"
- (5) Screen: Size \_\_\_\_\_, Length \_\_\_\_\_
- (6) Were any formations sealed against pollution?


yes, no.

If YES depth of formation \_\_\_\_\_

Why \_\_\_\_\_

Drillers Remarks: \_\_\_\_\_

CODED

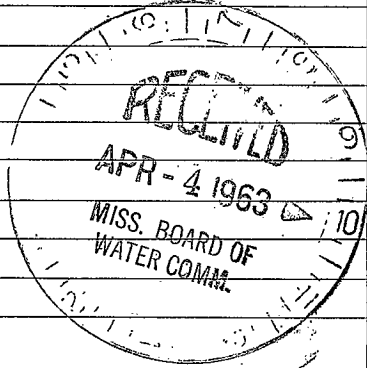

(Use Back Side)

Well No.

1000

1000

