

00C95
8-16-60

WATER WELL DRILLERS LOG

CODED

Date: 8-16, 1960, Driller: W. J. REEVES & SON County LOWNDES
 (Name)
 Call 3784026 - 11:00 12092 ON RIDGE RD. - W. E. McCLURE TURN RT. ON RD. ON LEFT

(1) Owner of Land: ROBT. STUBBS JR.
711 Gth AVE N. (Name) 3286665
COLUMBUS, MISS. (Address)
 (2) Location: NE SE SE 34 175180
1/4, 1/4, Sec. 34 T. 18 N. R. 6 W.
2 miles NE of COLUMBUS
 (distance) (direction) (Nearest Town)
 (3) Topography: HILLY
 (Hilly) (Flat) (Level)
 (4) Purpose of Well: IRRIGATION
 (Domestic Irrigation
 Municipal, Industrial, Other)

Description & Color of Materials Sand, Clay, Red Clay, Shell, etc.	Thick- ness Feet	Depth Feet
RED CLAY	26	0
" SAND	24	26
BLUE CLAY	32	50
WHITE SAND	8	82
BLUE CLAY & SAND	62	90
BLUE SAND	28	152
" CLAY	16	180
SAND-CLAY-ROCKS	21	196
BLUE CLAY	33	217
" SAND	15	250
BLUE CLAY-SAND STREAKS	40	265
SAND-CLAY STREAKS	55	305
BLUE SAND	9	360
" CLAY	66	369
WHITE SAND	20	435
PINK CLAY	40	455
SAND & GRAVEL	20	495
PINK CLAY	5	515
SAND	5	520
SAND & GRAVEL	36 1/2	525


Information upon completion of well:

(1) Diameter 4x2 1/2 inches.
 (2) Total Depth 561 1/2 feet.
 (3) Water Level 80 feet below top of ground.
 (4) Cased to 390' - 4" Size 2 1/2"
390' - 561 1/2'
 (5) Screen: Size 2 1/2" Length 25'
 (6) Were any formations sealed against pollution?
 _____ yes, _____ no.

If YES depth of formation _____
 Why _____

Drillers Remarks: _____

CODED

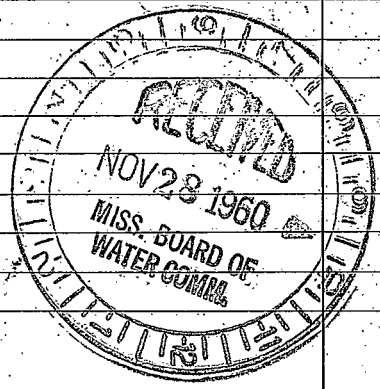

(Use Back Side)

Well No.

