

LOWNDES
G 104
7-20-72

MISSISSIPPI
 BOARD OF WATER COMMISSIONERS
 416 North State Street
 Jackson, Mississippi 39201

WATER WELL DRILLERS LOG

7-20 1972 W. J. REEVES & SON LOWNDES
 date well completed firm name county well located

LANDOWNER: REV. LAWRENCE PERKINS
PERKINS RD.

description of formations encountered from to

COLUMBUS
 (mailing address)

CLAY	0	11
SAND & GRAVEL	11	22
BLUE CLAY	22	46
BLUE SAND	46	53
BLUE CLAY	53	82
BLUE SAND	82	85
BLUE CLAY	85	91
BLUE SAND	91	118
BLUE CLAY	118	118
BLUE SAND	118	120

WELL LOCATION:
 sec. 21 T 17 N R 18 E
2 miles NO of COLUMBUS
 (distance) (direction) (nearest town)

WELL PURPOSE: HOME
 (home, irrigation, municipal, industrial)

WELL COMPLETION DATA:

- (1) diameter (inches) 4
- (2) total depth (feet) 120
- (3) static water level (feet) 10 below above top of ground.
- (4) casing STEEL, 2 1/2,
 (material) (depth)
4 if telescope see back.
 (size)
- (5) screen NONE
 (length) (depth to top)
 (size) (material)
- (6) pump _____
 (HP) (yield gpm)
 (type power)
- (7) electric log NO
 (yes or no)
 (organization running log)
- (8) how well bottom plugged OPEN


NOV 17 1972

DRILLERS REMARKS:

RECORDED BY _____
 INDEXED BY _____

If well telescopes please sketch and show depths.

GROUND LEVEL

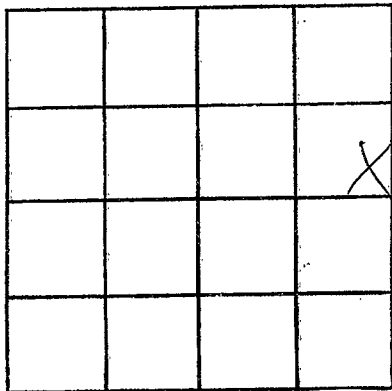

SECTION 21

Please indicate well location X.

ADDITIONAL INFORMATION

If more than one screen,
show locations of each on sketch.