

MISSISSIPPI  
 BOARD OF WATER COMMISSIONERS  
 416 North State Street  
 Jackson, Mississippi 39201

WATER WELL DRILLERS LOG

CODED

LOWNDES  
 C 105  
 9-30-72

9-30 1972 W. J. REEVES & SON LOWNDES  
 date well completed firm name county well located

LANDOWNER: ENDOW BROS.  
 AIR BASE RD.  
 COLUMBUS  
 (mailing address)

WELL LOCATION:  
 sec. 4 T-17 R-18 E  
 6 miles NO. of COLUMBUS  
 (distance) (direction) (nearest town)

WELL PURPOSE: IWP  
 (home, irrigation, municipal, industrial)

- WELL COMPLETION DATA:
- (1) diameter (inches) 4
  - (2) total depth (feet) 160
  - (3) static water level (feet) 15 below top of ground.
  - (4) casing ST 101 (material) (depth)  
 4 (size) if telescope see back.
  - (5) screen NONE (length) (depth to top)  
 (size) (material)
  - (6) pump (HP) (yield gpm)  
 (type power)
  - (7) electric log NO (yes or no)  
 (organization running log)
  - (8) how well bottom plugged OPEN

description of formations encountered	from	to
CLAY	0	19
SAND & GRAVEL	19	32
SANDY BOUE CLAY	30	47
" SAND	47	61
" CLAY	61	90
" SAND	94	96
" CLAY	96	121
BOUE SAND & CLAY	121	160


CODED

FEB 12 1973

DRILLERS REMARKS:

If well telescopes please sketch and show depths.

GROUND LEVEL

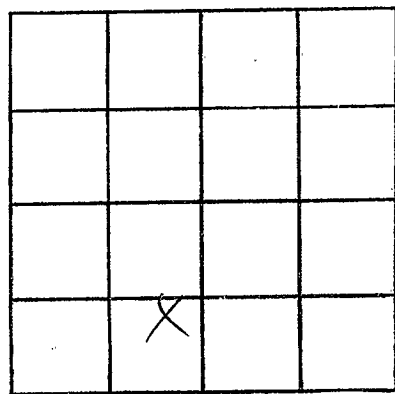

SECTION 4

Please indicate well location X.

ADDITIONAL INFORMATION

Lined area for additional information.

If more than one screen, show locations of each on sketch.