

LOWNDES

C 106

9-29-72

MISSISSIPPI
 BOARD OF WATER COMMISSIONERS
 416 North State Street
 Jackson, Mississippi 39201

WATER WELL DRILLERS LOG

CODED

9-29 1972 W. J. REEVES & SON LOWNDES
 date well completed firm name county well located

LANDOWNER: ENLOW BROS.

description of formations encountered

from

to

AIR BASE RD.

CLAY

0 18

COLUMBUS

SAND & GRAVEL

18 32

(mailing address)

BLUE CLAY

32 40

WELL LOCATION:

" SAND

40 54

sec. 4 T-17 R-18
 6 miles NO of COLUMBUS
 (distance) (direction) (nearest town)

" CLAY

54 63

" SAND

63 76

" CLAY

76 115

" SAND

115 121

WELL PURPOSE: IND.
 (home, irrigation, municipal, industrial)

" CLAY

121 134

" SAND

134 160

WELL COMPLETION DATA:

(1) diameter (inches) 4

(2) total depth (feet) 100

(3) static water level (feet) 15 below above top of ground.

(4) casing ST 81 (material) (depth)

4 (size) if telescope see back.

(5) screen NONE (length) (depth to top)

(size) (material)

(6) pump (HP) (yield gpm)

(type power)

(7) electric log NO (yes or no)

(organization running log)


(8) how well bottom plugged OPEN

DRILLERS REMARKS:

FEB 19 1973

If well telescopes please sketch and show depths.

GROUND LEVEL

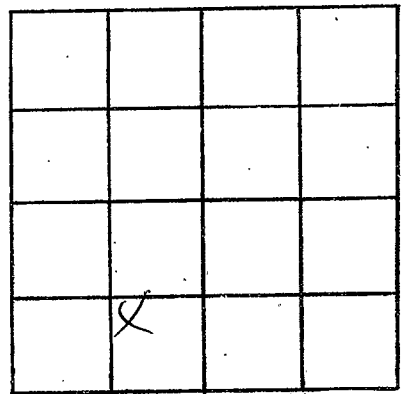

SECTION 4

Please indicate well location X.

ADDITIONAL INFORMATION

A series of horizontal lines for writing additional information.

If more than one screen, show locations of each on sketch.