

LOWNDES
C 107
2-1-73

MISSISSIPPI
BOARD OF WATER COMMISSIONERS
416 North State Street
Jackson, Mississippi 39201

CODED

WATER WELL DRILLERS LOG

2-1 1973 W. J. REEVES, JR. LOWNDES
date well completed firm name county well located

LANDOWNER: J. H. SUTTON

SLEEPY HOLLOW S/D

COLOMBUS

(mailing address)

WELL LOCATION:

sec. 32 T 17 R 18 S W
1 miles NO of COLOMBUS
(distance) (direction) (nearest town)

WELL PURPOSE: NONE
(home, irrigation, municipal, industrial)

WELL COMPLETION DATA:

- (1) diameter (inches) 4
- (2) total depth (feet) 280
- (3) static water level (feet) 109 below top of ground.
- (4) casing STEEL, 141 (material), (depth)
4 (size) if telescope see back.
- (5) screen NONE (length), (depth to top)
(size), (material)
- (6) pump 1 (HP), 15 (yield gpm)
EJECT (type power)
- (7) electric log NO (yes or no)
(organization running log)
- (8) how well bottom plugged OPEN

description of formations encountered

from

to

CLAY	0	17
SANDY BLUE CLAY	17	114
BLUE CLAY + SAND	114	156
BLUE CLAY	156	208
BLUE SAND	208	221
" CLAY	221	246
" SAND	246	270
" CLAY	270	280


COPIED

FEB 14 1973

DRILLERS REMARKS:

If well telescopes please sketch and show depths.

GROUND LEVEL

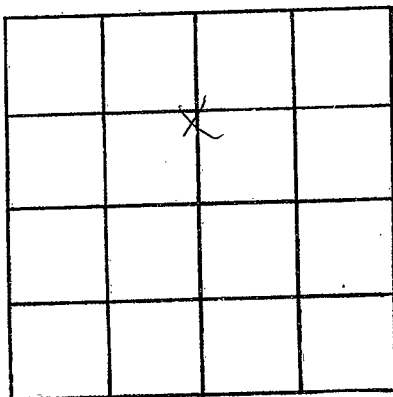

SECTION 32

Please indicate well location X.

ADDITIONAL INFORMATION

If more than one screen, show locations of each on sketch.