

LOWNDES

C 108

2-6-73

MISSISSIPPI
 BOARD OF WATER COMMISSIONERS
 416 North State Street
 Jackson, Mississippi 39201

CODED

WATER WELL DRILLERS LOG

2-6 1973
date well completed

W. J. REEVES & SON
firm name

LOWNDES
county well located

LANDOWNER: CHARLES COLE

description of formations encountered

from

to

SLEEPY HOLLOW S/D

COLUMBUS

(mailing address)

WELL LOCATION:

sec. 32 T 17 N R 18 E
 S W
 1 miles No of COLUMBUS
 (distance) (direction) (nearest town)

CLAY	0	17
RR SAND	17	28
RANDY BLUE CLAY	28	144
BLUE CLAY	144	195
" SAND	195	203
" CLAY	203	246
" SAND	246	272
" CLAY	272	282

WELL PURPOSE: HOME
(home, irrigation, municipal, industrial)

WELL COMPLETION DATA:

- (1) diameter (inches) 4
- (2) total depth (feet) 280
- (3) static water level (feet) 114 below top of ground.
- (4) casing STEEL, 150 1/2 (material), (depth)
4 (size) if telescope see back.
- (5) screen NONE (length), (depth to top)
(size), (material)
- (6) pump 1 (HP), 15 (yield gpm)
ELECT (type power)
- (7) electric log No (yes or no)
(organization running log)
- (8) how well bottom plugged OPEN


CODED

FEB 14 1973

DRILLERS REMARKS:

If well telescopes please sketch and show depths.

GROUND LEVEL

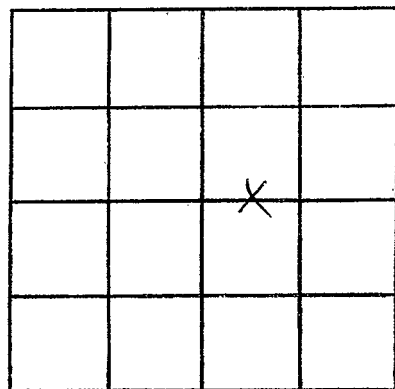

SECTION 32

Please indicate well location X.

ADDITIONAL INFORMATION

If more than one screen,
show locations of each on sketch.