

LOWNDES
C 114
6-19-73

MISSISSIPPI
BOARD OF WATER COMMISSIONERS
416 North State Street
Jackson, Mississippi 39201

CODED

WATER WELL DRILLERS LOG

6-19 1973 W.J. REEVES & SON LOWNDES
date well completed firm name county well located

LANDOWNER: JAMES VAN

description of formations encountered from to

LANDING HAM

RT. 6 COLUMBUS
(mailing address)

CLAY 0 17

WELL LOCATION:

SD 2 GRAVEL 17 36

sec. 5 T. 17 R. 18

BLUE CLAY 36 120

10 miles N of COLUMBUS
(distance) (direction) (nearest town)

" SAND 120 160

WELL PURPOSE: HOME
(home, irrigation, municipal, industrial)

WELL COMPLETION DATA:

(1) diameter (inches) 4

(2) total depth (feet) 160

(3) static water level (feet) 18 below top of ground.

(4) casing STL 42
(material) (depth)

4 if telescope see back.
(size)

(5) screen
(length) (depth to top)

(size) (material)

(6) pump
(HP) (yield gpm)

(type power)

(7) electric log NO
(yes or no)

CODED

(organization running log)


(8) how well bottom plugged OPEN

DRILLERS REMARKS:

MAY 20 1973
MISS. Bd. OF WATER COM.

If well telescopes please sketch and show depths.

GROUND LEVEL

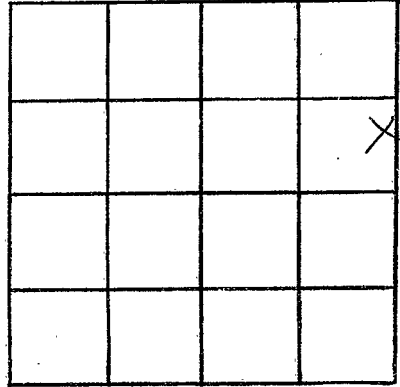

SECTION 5

Please indicate well location X.

ADDITIONAL INFORMATION

If more than one screen, show locations of each on sketch.