

LOWNDES

C 118

8-5-74

MISSISSIPPI
 BOARD OF WATER COMMISSIONERS
 416 North State Street
 Jackson, Mississippi 39201

CODED

WATER WELL DRILLERS LOG
 CLARDY WELL AND PUMP SERVICE

513 WARPATH ROAD

COLUMBUS, MISS. 39701

Lowndes county well located

Aug 5 1974
date well completed

LANDOWNER: Mike Bradshaw

description of formations encountered

from to

P O Box 1243

clay

0 8

Columbus, Miss

sand + gravel

8 27

(mailing address)

blue clay

27 35

WELL LOCATION:

sandy blue clay

35 50

sec. 7 T 17 R 18

blue clay

50 60

5 miles N of Col

sandy blue clay

60 70

(distance) (direction) (nearest town)

blue clay

70 90

WELL PURPOSE: home
(home, irrigation, municipal, industrial)

fine sand

90 115

WELL COMPLETION DATA:

blue clay

115 130

(1) diameter (inches) 4"

sand

130 165

(2) total depth (feet) 165

(3) static water level (feet) 28 below top of ground.

(4) casing steel 54' (material) (depth)

CODED

(size) if telescope see back.

(5) screen 0 0 (length) (depth to top)

(size) (material)

(6) pump 1/2 Sub 12 (HP) (yield gpm)

(type power)

(7) electric log (yes or no)

(organization running log)

(8) how well bottom plugged


RECEIVED
OCT 17 1974

DRILLERS REMARKS:

MISS. BD. OF WATER COM

If well telescopes please sketch and show depths.

GROUND LEVEL

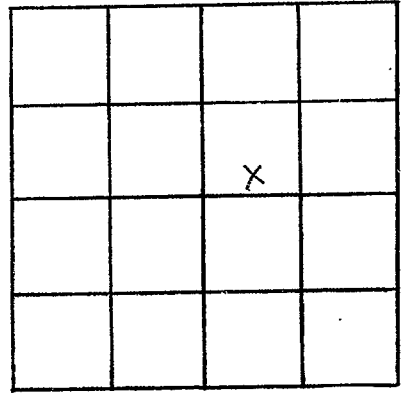

SECTION 7

Please indicate well location X.

ADDITIONAL INFORMATION

If more than one screen,
show locations of each on sketch.