

**LOWNDES**  
**C 121**  
**7-31-74**

MISSISSIPPI  
 BOARD OF WATER COMMISSIONERS  
 416 North State Street  
 Jackson, Mississippi 39201

WATER WELL DRILLERS LOG

CODED

7-31 1974 W. J. REEVES & SON LOWNDES  
 date well completed firm name county well located

LANDOWNER: DR. A. R. DICK  
RT. 6  
COLUMBUS  
 (mailing address)

WELL LOCATION:  
 sec. 32 T. 17 N. R. 18 E  
 S W  
1 miles NW of COLUMBUS  
 (distance) (direction) (nearest town)

WELL PURPOSE: HOME  
 (home, irrigation, municipal, industrial)

- WELL COMPLETION DATA:
- (1) diameter (inches) 4
  - (2) total depth (feet) 280
  - (3) static water level (feet) 102 below  
 top of ground.
  - (4) casing ST2, 148,  
 (material) (depth)  
4 if telescope see back.  
 (size)
  - (5) screen NONE,  
 (length) (depth to top)  
 (size) (material)
  - (6) pump 1 12  
 (HP) (yield gpm)  
ELECT  
 (type power)
  - (7) electric log No  
 (yes or no)  
 (organization running log)
  - (8) how well bottom plugged OPEN

description of formations encountered	from	to
CLAY	0	21
SANDY BLUE CLAY	21	112
BLUE CLAY	112	191
" SAND	191	202
" CLAY	202	220
" SAND	220	228
" CLAY	228	234
" SAND	234	260
BLUE CLAY + SAND	260	280


CODED

RECORDED  
 MAR 17 1975

DRILLERS REMARKS:

If well telescopes please sketch and show depths.

GROUND LEVEL

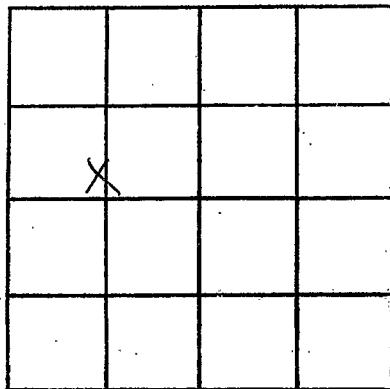

SECTION 32

Please indicate well location X.

ADDITIONAL INFORMATION

If more than one screen,  
show locations of each on sketch.