

**LOWNDES**  
**C 122**  
**3-31-75**

MISSISSIPPI  
 BOARD OF WATER COMMISSIONERS  
 416 North State Street  
 Jackson, Mississippi 39201

**CODED**

**WATER WELL DRILLERS LOG**

023

Mar 31 1975 CLARDY Well + pump Lowndes  
 date well completed firm name county well located

LANDOWNER: Sgt D.A. Peeples  
924 Airbase Rd.  
Columbus, Miss 39701  
 (mailing address)

description of formations encountered	from	to
clay	0	12
sand + gravel	12	25
blue clay	25	40
sandy blue clay	40	60
blue clay	60	100
sandy blue clay	100	115
blue clay	115	160
streaks of sand + clay	160	200

WELL LOCATION:  
 sec. 5 T 17 N R 18 E  
5 miles N of Col  
 (distance) (direction) (nearest town)

WELL PURPOSE: home  
 (home, irrigation, municipal, industrial)

WELL COMPLETION DATA:

- (1) diameter (inches) 4"
- (2) total depth (feet) 200
- (3) static water level (feet) 25 below above top of ground.
- (4) casing steel, 68  
 (material) (depth)  
 \_\_\_\_\_ If telescope see back.  
 (size)
- (5) screen \_\_\_\_\_  
 (length) (depth to top)  
 \_\_\_\_\_ (size) \_\_\_\_\_ (material)
- (6) pump 1/2 Sub 12  
 (HP) (yield gpm)  
 \_\_\_\_\_ (type power)
- (7) electric log \_\_\_\_\_  
 (yes or no)  
 \_\_\_\_\_ (organization running log)
- (8) how well bottom plugged \_\_\_\_\_

DRILLERS REMARKS: \_\_\_\_\_


**RECEIVED**

MAY 7 1975

MISS. BD. OF WATER COMMISSIONERS

If well telescopes please sketch and show depths.

GROUND LEVEL

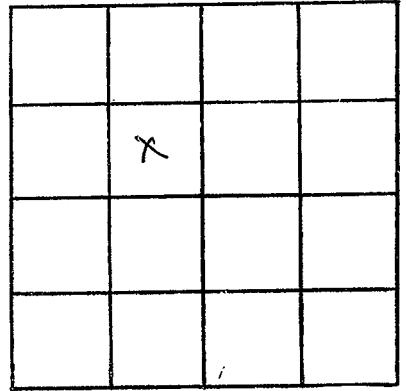

SECTION 5

Please indicate well location X.

ADDITIONAL INFORMATION

If more than one screen, show locations of each on sketch.