

LOWNDES
C 126
4-5-79


MISSISSIPPI
BOARD OF WATER COMMISSIONERS
416 North State Street
Jackson, Mississippi 39201 **CODED**
WATER WELL DRILLERS LOG

April 5 1979 Mid South Devel. Co. Loundes
date well completed firm name county well located

LANDOWNER:	description of formations encountered	from	to
Danny Watson Rt. 5 Box 113 Columbus, MS 39701 (mailing address)	clay	10	15
	sand & gravel	15	44
WELL LOCATION: sec. 24 T 17 S R 18 E 4 miles N of Columbus (distance) (direction) (nearest town)	clay	44	60
	clay & sand	60	120
WELL PURPOSE: Irrigation (home, irrigation, municipal, industrial)	clay CODED	120	135
WELL COMPLETION DATA:	clay & sand	135	165
(1) diameter (inches) 6	clay	165	195
(2) total depth (feet) 350	clay & sand	195	270
(3) static water level (feet) 53 below top of ground.	clay	270	281
(4) casing PVC 315 (material) (depth) 4-6 (size) if telescope see back. ✓	sand	281	300
(5) screen 47, 315 (length) (depth to top) 4, PVC (size) (material)	sand & gravel	300	345
(6) pump 5 180 (HP) (yield gpm) electric (type power)	sand	345	360
(7) electric log no (yes or no) no (organization running log)			
(8) how well bottom plugged screen			
DRILLERS REMARKS:			

Miss. Board of Water Comm.

MAY 21 1979

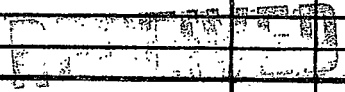

⑦


If well telescopes please sketch and show depths.

GROUND LEVEL

6" casing
PVC 165'

4" casing
PVC 150'

47' screen
PVC
.018

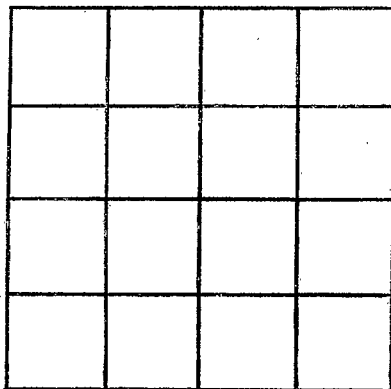

SECTION _____

Please indicate well location X.

ADDITIONAL INFORMATION

If more than one screen,
show locations of each on sketch.