

(X)

If well telescopes please sketch and show depths.

GROUND LEVEL


6" PVC
145'



4" PVC
180'



40' 4"
PVC
.018

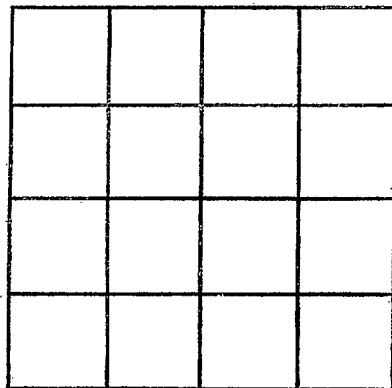

SECTION _____

Please indicate well location X.

ADDITIONAL INFORMATION

If more than one screen, show locations of each on sketch.