

MISSISSIPPI DEPARTMENT OF NATURAL RESOURCES

Bureau of Land and Water Resources

Southport Mall

P.O. Box 10631

Jackson, Mississippi 39209

WATER WELL DRILLERS LOG

LOWNDES  
C 128 C  
11/6/82

*Griner Drilling Service, Inc.*

*Lowndes*

11-6-82 date well completed      Griner Drilling Service, Inc. firm name      Lowndes county well located

LANDOWNER:	description of formations encountered	from	to
<i>Pruett Production</i> <i>1515 Capital Towers</i> <i>Jackson, Ms. 39205</i> (mailing address)	<i>clay</i>	<i>0</i>	<i>15</i>
WELL LOCATION: <i>440' N + 1500' E</i> sec. <i>3</i> T. <i>17</i> N. R. <i>18</i> SW/40	<i>gravel</i>	<i>15</i>	<i>30</i>
<i>No 1 Stanley Wells Field</i> <i>3 1/4 miles (distance) N (direction) of (nearest town)</i>	<i>clay, red</i>	<i>30</i>	<i>210</i>
WELL PURPOSE: <i>oil field supply</i> (home, irrigation, municipal, industrial)	<i>streaked</i>	<i>210</i>	<i>295</i>
	<i>sand, gravel</i>	<i>295</i>	<i>357</i>

WELL COMPLETION DATA:

- (1) diameter (inches) 3'
- (2) total depth (feet) 357'
- (3) static water level (feet) 506' *(below)* above top of ground.
- (4) casing steel 357'  
(material) (depth)  
3"  
(size) if telescope see back.
- (5) screen 42' 315'  
(length) (depth to top)  
3" perforated  
(size) (material)
- (6) pump — 75-80  
(HP) (yield gpm)  
AC  
(type power)
- (7) electric log —  
(yes or no)  
—  
(organization running log)

**CODED**

DEPT. OF NATURAL RESOURCES  
BUREAU OF LAND & WATER RESOURCES

NOV 22 1982


**RECEIVED**

(8) how well bottom plugged orange  
peel

DRILLERS REMARKS: —

If well telescopes please sketch and show depths.

GROUND LEVEL

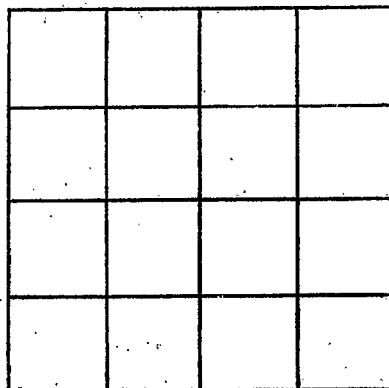

SECTION \_\_\_\_\_

Please indicate well location X.

ADDITIONAL INFORMATION

If more than one screen, show locations of each on sketch.