

MISSISSIPPI DEPARTMENT OF NATURAL RESOURCES

Bureau of Land and Water Resources

Southport Mall

P.O. Box 10631

Jackson, Mississippi 39209

CODED

WATER WELL DRILLERS LOG

LOWNDES  
C129  
5/20/83

5-20 1983 Claridy Well Drilling Lowades  
date well completed      firm name      county well located

LANDOWNER: Paul Gordon  
3723 Northdale Dr.  
Columbus, Miss.  
(mailing address)

WELL LOCATION:  
sec. 29 T. 17 N. R. 18 E.  
2 miles W. of Colo.  
(distance) (direction) (nearest town)

WELL PURPOSE: home  
(home, irrigation, municipal, industrial)

WELL COMPLETION DATA:

(1) diameter (inches) 4"

(2) total depth (feet) 330'

(3) static water level (feet) 7' below above top of ground.

(4) casing PVC 155'  
(material) (depth)

4"  
(size) if telescope see back.

(5) screen \_\_\_\_\_  
(length) (depth to top)

(size) (material)

(6) pump 3/4 850 gph.  
(HP) (yield gpm)

elec  
(type power)

(7) electric log no  
(yes or no)

\_\_\_\_\_  
(organization running log)

(8) how well bottom plugged \_\_\_\_\_

description of formations encountered	from	to
red clay	0	20
sandy blue clay	20	24 1/2
rock	24 1/2	25
sandy clay	25	108
rock	108	109
sandy clay	109	129
fine clay	129	134
good clay	134	137
sand	137	149
good clay	149	186
sand	186	189
clay	189	191
sand	191	192
sandy clay	192	213
sand	213	215
sandy clay	215	301
sand	301	303
sandy clay	303	330

CODED

DEPT. OF NATURAL RESOURCES  
BUREAU OF LAND & WATER RESOURCES


JUN 20 1983

RECEIVED

DRILLERS REMARKS: \_\_\_\_\_

If well telescopes please sketch and show depths.

GROUND LEVEL

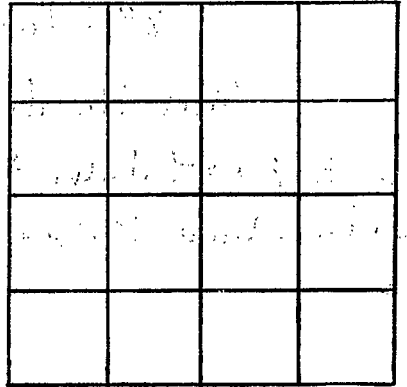

SECTION \_\_\_\_\_

Please indicate well location X.

ADDITIONAL INFORMATION

If more than one screen, show locations of each on sketch.