

Lowndes

C 133

6-29-85

MISSISSIPPI
 BOARD OF WATER COMMISSIONERS
 416 North State Street
 Jackson, Mississippi 39201

CODED

WATER WELL DRILLERS LOG

6-29-85 Griner Drilling Service, INC.

Lowndes

date well completed

firm name

county well located

LANDOWNER:

Pruet Production
 217 West Capitol St.
 Suite 201
 Jackson, Miss 39201

description of formations encountered

from

to

clay, sand

0

30

gravel

30

58

clay, rock

58

270

sand

270

315

WELL LOCATION: 2514' N of 1100' W

No. 1 sec. 5 T. 17 N. R. 18 E. of section
 Gates 59 Spinson Cr. Field
 (distance) (direction) (nearest town)

WELL PURPOSE: oil field supply (home, irrigation, municipal, industrial)

WELL COMPLETION DATA:

- (1) diameter (inches) 3"
- (2) total depth (feet) 315'
- (3) static water level (feet) 40' ^{below} top of ground
- (4) casing steel, 315' (material) (depth)
 3" (size) if telescope see back.
- (5) screen 42', 273' (length) (depth to top)
 3" perforated (size) (material)
- (6) pump 75-80 (HP) (yield gpm)
 AC (type power)
- (7) electric log (yes or no)

(organization running log)

(8) how well bottom plugged orange peel


DRILLERS REMARKS:

RECEIVED

JUL 11 1985

If well telescopes please sketch and show depths.

GROUND LEVEL

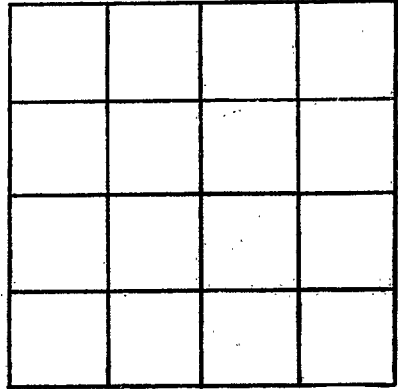

SECTION _____

Please indicate well location X.

ADDITIONAL INFORMATION

If more than one screen,
show locations of each on sketch.