

MISSISSIPPI DEPARTMENT OF NATURAL RESOURCES

Bureau of Land and Water Resources

Southport Mall

P.O. Box 10631

Jackson, Mississippi 39209

WATER WELL DRILLERS LOG

LOWNDES
C 134
11-7-85

11-7-85 date well completed      Clardy Well Drilling firm name      Lowndes county well located

LANDOWNER: Midway Missionary Baptist Ch.  
Rt 5 Col. MS-  
 (mailing address)

WELL LOCATION:  
 sec 30 T 17 N R 18 E  
1 1/2 miles NE of Col.  
 (distance) (direction) (nearest town)

WELL PURPOSE: home  
 (home, irrigation, municipal, industrial)

- WELL COMPLETION DATA:
- (1) diameter (inches) 4"
  - (2) total depth (feet) 123'
  - (3) static water level (feet) 38' below above top of ground.
  - (4) casing PVC 106  
 (material) (depth)  
4"  
 (size) if telescope see back.
  - (5) screen \_\_\_\_\_  
 (length) (depth to top)  
 (size) (material)
  - (6) pump 1/2 850 gph  
 (HP) (yield gph)  
elec  
 (type power)
  - (7) electric log no  
 (yes or no)  
 (organization running log)
  - (8) how well bottom plugged \_\_\_\_\_

description of formations encountered	from	to
sand & clay	0	25
sandy thin clay	25	55
rock	55	89
thin clay	89	97
rock	97	98
rock	98	101
sandy clay	101	120
sand	120	123
rock	123	
sandy clay	123	180


RECEIVED  
 DEC 20 1985

Department  
 Bureau of

DRILLERS REMARKS:

If well telescopes please  
sketch and show depths.

GROUND LEVEL

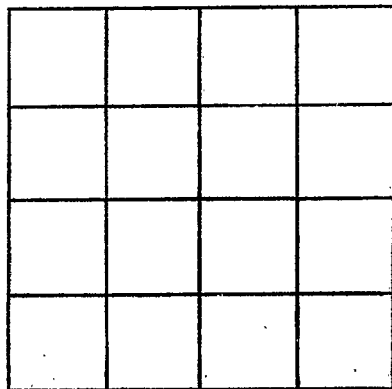

SECTION \_\_\_\_\_

Please indicate well location X.

ADDITIONAL INFORMATION

If more than one screen,  
show locations of each on sketch.