

art a never-received 4/13 State W	S
For Office Use Only:	
	arti
1	t of Environmental Quality Aquifer:
	nd Water Resources Box 10631 Well #:
Driller VIIII CULL IIII VVII	
	IS 39289-0031 L. S. Elevation: 961-5210
(601)354	4-6938 (fax) E-log #:
large Prilling and Excavation	
State Law requires that this report be prepared by the 30 days of completion of drilling of the well.	·
Well Owner Information	Well Location
Dwner Name James Laylor	Latitude: <u>33 • 35 • 15 "</u> Longitude: <u>88 • 27 • 15 "</u>
Mailing Address: P.O. Box 1934	Method of Lat/Long (circle one): Conventional Survey,
Columbre, 678	USGS quad, Hand-held GPS, Survey-grade GPS
39705	5 4 14 Sec 18 Twn 175 Rng 18 W
City State Zip Code	SE NE Distance Direction Nearest Town
Telephone No. (662) 574 - 4298	<u>A 4 Miles</u> N.W of <u>Columbrus</u>
Well I	Data
Purpose of Well (circle one Home Industrial Public Supply Irrigation Fish Culture Other:	
Date well drilling started: 12804 Date	well drilling completed: 12/15/04
If flowing, method of flow regulation: Valve Other (d	escribe)
Static Water Level: feet above or below (circle one) h	and surface Date measured: 12804
Method of Measurement (circle one) steel tape electric tape	air line other:
Hole depth: 167 Well depth: 167	Well grouted to a depth offeet
Type of grout (circle one): Cement Bentonite Mix	
Casing length: <u>88</u> feet Casing diameter: <u>4"</u>	_inches Type of casing:
Screen length: <u>40</u> ¹ feet Screen diameter: <u>a¹¹</u>	inches Type of screen: <u>PVC</u>
Screen slot size: .013 inches Setting depth: From _	127 feet to 167 feet
Type of completion (circle all applicable): Gravel packed Under	reamed Telescoped Open hole Natural Development
Other (describe):	
Top of lap pipe or reduction in casing:	lescoped or more than one screen, describe on back of page
Logs run (circle all applicable): No log run Electric Gamma Ray	Density Sonic Neutron Other:
Name of organization running log(s):	
I certify that the well was drilled, constructed, and completed in a	
Department of Environmental Quality and/or the Mississippi Dep	artment of Health regulations and state laws.
Donald B. Clardy 0-4	96 Calital
Print Name of Water Well Contractor and License No.	Signature of Water Well Contractor
	ا اور به الاست. این معنی می ایر معمد الاست. ایر معمد الاست.

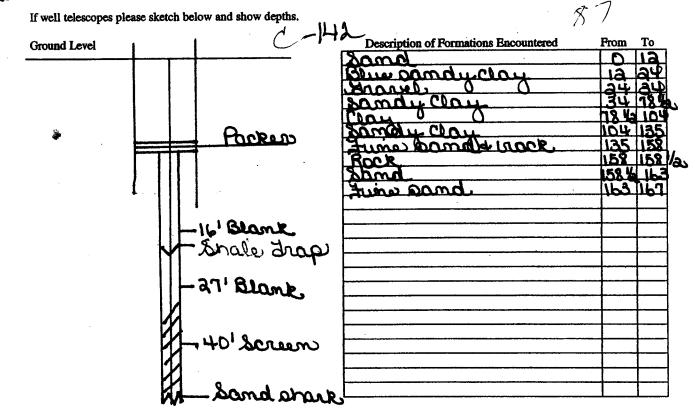

If more than one screen, show location of each on sketch

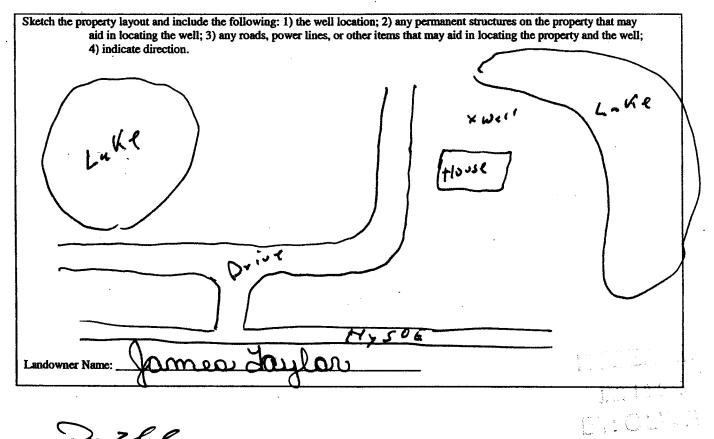

Signature of Water Well Contractor

Signature of water well Contrac