

County: Lorain  
 Permit #: \_\_\_\_\_  
 Driller: Clardy Drill  
 Date drilling completed: 6/10/08

**State Well Report**  
**Part 1 – Driller's Log**  
 Mississippi Department of Environmental Quality  
 Office of Land and Water Resources  
 P.O. Box 10631  
 Jackson, MS 39289-0631  
 (601)961-5210  
 (601)354-6938 (fax)

**For Office Use Only:**  
 Aquifer: \_\_\_\_\_  
 Well #: OC-150  
 L. S. Elevation: \_\_\_\_\_  
 E-log #: \_\_\_\_\_

*State Law requires that this report be prepared by the license holder responsible for the work and filed with the Department at the above address within 30 days of completion of drilling of the well or borehole.*

<p><b>Information on Well Owner</b>          (Landowner if borehole is not for a water well)</p> <p>Owner Name: <u>Charles Eddie</u>          Mailing Address: <u>476 Forest Glen Rd.</u>  <u>Columbus, MS 39705</u>          City State Zip Code          Telephone No. <u>(662) 328-5102</u></p>	<p><b>Well or Borehole Location</b></p> <p>Latitude: <u>33° 36' 730</u> Longitude: <u>088° 29' 150</u>  <u>99</u> <u>09</u></p> <p>Method of Lat/Long (circle one): Conventional Survey,          USGS quad <u>Hand-held GPS</u>, Survey-grade GPS</p> <p>IR <u>1/4</u> SW <u>1/4</u> Sec <u>1</u> Twn <u>13</u> Rng <u>19W</u>  <u>75</u></p> <p>Distance <u>5</u> Miles Direction <u>NW</u> of Nearest Town <u>Columbus</u></p>
--	---

**Well / Borehole Data**

Date drilling started: 6/9/08 Date drilling completed: 6/10/08 Hole depth: 182 Hole diameter: 4"

Location of the source of any surface water used for drilling: \_\_\_\_\_  
 Method of dosing and volume of Chlorine used in drilling and development: 2 1/2 # granular

Logs run (circle all applicable): No log run Electric Gamma Ray Density Sonic Neutron Other: \_\_\_\_\_  
 Name of organization running log(s): \_\_\_\_\_

Purpose of borehole (check one): Water Well  Geotechnical/Geological Investigation \_\_\_\_\_ Ground Source Heat Pump \_\_\_\_\_  
 Seismic Survey \_\_\_\_\_ Other (describe) \_\_\_\_\_

*If drilling is not related to water well construction, skip the remainder of this block*

Purpose of Well (check one): Home  Industrial \_\_\_\_\_ Public Supply \_\_\_\_\_ Irrigation \_\_\_\_\_ Fish Culture \_\_\_\_\_ Other: \_\_\_\_\_

If a flowing well, method of flow regulation: Valve \_\_\_\_\_ Other (describe) \_\_\_\_\_

Static Water Level: 11 feet above or below (circle one) land surface Date measured: 6/10/08

Method of Measurement (circle one) steel tape electric tape air line other: \_\_\_\_\_

Well depth: 182 Well grouted to a depth of 20 feet Type of grout (circle one): Neat Cement Bentonite Mix

Casing length: 82 1/2 feet Casing diameter: 4 inches Type of casing: PVC

Screen length: 40 feet Screen diameter: 2 inches Type of screen: PVC

Screen slot size: .013 inches Setting depth: From 84 feet to 124 feet

Type of completion (circle all applicable): Gravel packed Underreamed Telescoped Open hole Natural Development  
 Other (describe): \_\_\_\_\_


Top of lap pipe or reduction in casing: 5 feet. *If telescoped or more than one screen, describe on next page*

Form: OLWR-SWR-1A

RECEIVED  
 JUL 03 2008  
 BY: OLWR

The sketch below only required for water wells

If well telescopes, show depths on sketch.

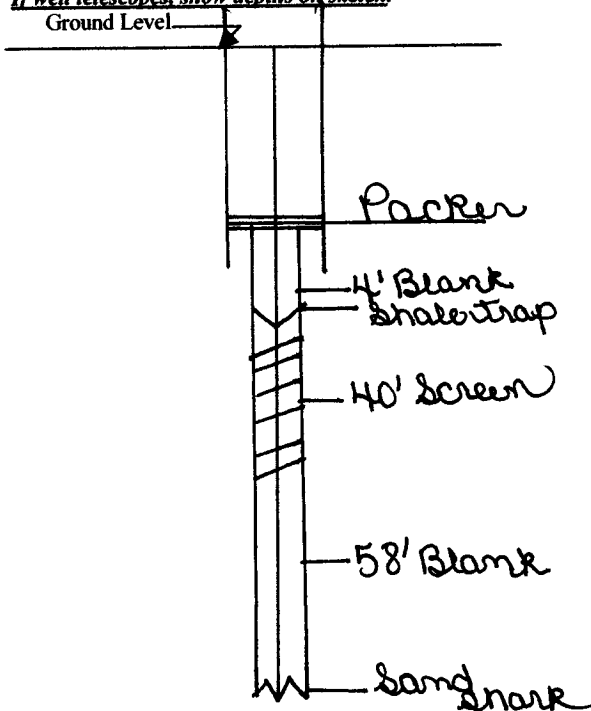


Description of formations encountered must be provided for all wells and boreholes, unless specifically exempted by regulations

Description of Formations Encountered	From (depth)	To (depth)
Sandy Red Clay	Ground Level	17
Sandy gravel	17	29
Sandy blue clay	29	115
Rocky Clay	115	124
Clay	124	157
Sand streak	157	162
Sandy clay	162	182

If more than one screen, show location of each on sketch

Sketch the property layout and include the following: 1) the well location; 2) any permanent structures on the property that may aid in locating the well; 3) any roads, power lines, or other items that may aid in locating the property and the well; 4) a north arrow.

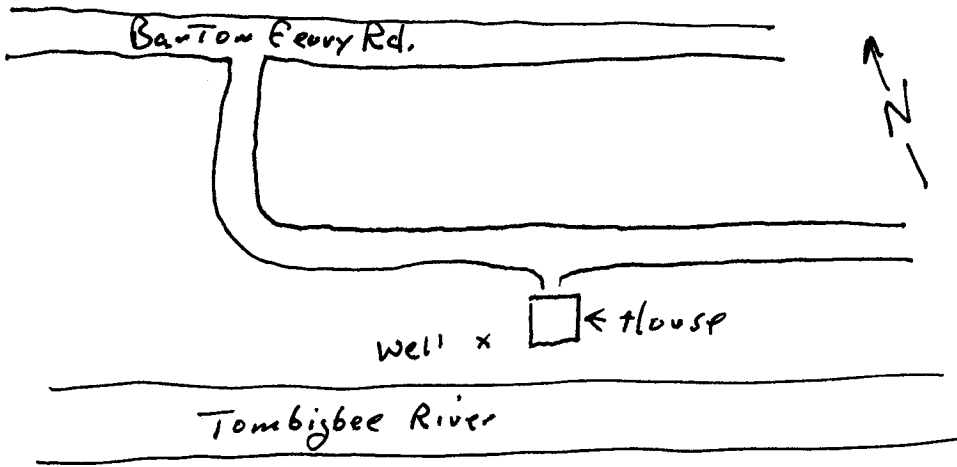

Landowner Name: Charles Ellis

Form: OLWR-SWR-1A

I certify that the well/borehole was drilled, constructed, and completed in accordance with all applicable requirements of the Mississippi Department of Environmental Quality and the Mississippi Department of Health regulations, if applicable, and state laws.

Donald B. Clardy 0-496      7/1/08  
 Print Name of Responsible Licensee and License No.      Date

[Signature]  
 Signature of Licensee

RECEIVED  
 JUL 03 2008  
 BY: OLWR

# STATE WELL REPORT

## Part 2

**Pump Installer's Completion Report**  
 Mississippi Department of Environmental Quality  
 Office of Land and Water Resources  
 P.O. Box 10631  
 Jackson, MS 39289-0631  
 (601)961-5210  
 (601)354-6938 (fax)

County: Leakland  
 Permit #: \_\_\_\_\_  
 Driller: Clardy Rule  
 Date completed: 6/10/08  
*Copy information from block on Part 1*

**For Office Use Only:**

Aquifer: \_\_\_\_\_  
 Well #: C-150  
 Elevation: \_\_\_\_\_

*This part of the report must be completed by a licensed water well contractor or a licensed pump installer. A copy of Part 1 of the report must be attached and both parts filed with the Department at the above address within 30 days of well completion.*

Well Owner Information	Well Location
Owner Name: <u>Charles Ellis</u>	Latitude: <u>N 33° 36.730</u> Longitude: <u>W 088° 29.150</u>
Mailing Address: <u>4716 Forest Glen Rd.</u>	Method of Lat/Long (check one): Conventional Survey _____
<u>Columbus, MS 39705</u>	USGS quad _____, Hand-held GPS _____, Survey-grade GPS _____
City State Zip Code	_____ ¼ _____ ¼ Sec <u>1 T 17s R 19w</u>
Telephone No. <u>662 328-5102</u>	Distance Direction Nearest Town
	<u>5</u> Miles <u>NW</u> of <u>Columbus</u>

Pump Type Circle one	Power Type Circle one
Air Lift                      Jet <u>Submersible</u>	Diesel Engine                      Gasoline Engine                      Natural Gas
Bucket                      Piston                      Turbine	<u>Electric Motor</u> Hand                      Tractor PTO
Centrifugal                      Rotary                      Flowing Well	Windmill                      Other (specify): _____
Other (specify): _____	Horse Power Rating of Motor: <u>3/4</u>
Date Pump Installed: _____	Setting Depth: <u>60</u> feet
Rated Pump Capacity: <u>20</u> Gallons Per Minute	Number of Stages: <u>10</u>

Pump Test Data	Method of Measuring Water Level Circle one
Date Well Tested: <u>6/10/08</u>	Air Line                      Electric Measuring Line <u>Steel Tape</u>
Static Water Level (A): <u>11</u> Feet Below Land Surface	Other (specify): _____
Pumping Water Level (B): _____ Feet Below Land Surface	For flowing well, measured shut in head: _____ feet
Drawdown [(B) - (A)]: _____ Feet Below Land Surface	Well yielded _____ GPM with a drawdown of _____ feet after _____ hours of pumping
Test Pumping Rate: <u>15</u> Gallons Per Minute	
Duration of Pump Test (minimum 4 hours): _____ hours	

I HEREBY CERTIFY that the above statements are true to the best of my knowledge.

Donald B. Clardy 0-496                      Don Clardy  
 Print Name of Pump Installer and License No. (if applicable)                      Signature of Pump Installer

Form: OLWR-SWR-1B

RECEIVED

JUL 03 2008

BY: OLWR