

**MISSISSIPPI  
BOARD OF WATER COMMISSIONERS**  
416 North State Street  
Jackson, Mississippi 39201

**WATER WELL DRILLERS LOG**

Lowndes  
C 7002  
5-67

5-16 1967 W. J. REEVES 2 SON LOWNDES  
date well completed firm name county well located

LANDOWNER: FRED TAYLOR

description of formations encountered	from	to

RT. 5

COLUMBUS  
(mailing address)

**WELL LOCATION:**

sec 5 T 17 S R 18 E W  
8 miles N of COLUMBUS  
(distance) (direction) (nearest town)


WELL PURPOSE: HOME  
(home, irrigation, municipal, industrial)

**WELL COMPLETION DATA:**

- (1) diameter (inches) 4
- (2) total depth (feet) 157
- (3) static water level (feet) 21 <sup>below</sup> above top of ground.
- (4) casing STEEL 38 1/2  
(material) (depth)  
4" if telescope see back.  
(size)
- (5) screen NONE  
(length) (depth to top)  
(size) (material)
- (6) pump 1/2 8  
(HP) (yield gpm)  
ELECT  
(type power)
- (7) electric log NO  
(yes or no)  
(organization running log)
- (8) how well bottom plugged OPEN


CLAY	0	9
SAND & GRAVEL	9	24
BLUE CLAY	24	26
" SAND	26	29
" CLAY	29	34
" SAND	34	34
" CLAY	34	60
" SAND	60	65
" CLAY	65	75
" SAND	75	77
" CLAY	77	86
" SAND	86	89
" CLAY	89	101
" SAND	101	103
" CLAY	103	106
" SAND	106	109
" CLAY	109	129
" SAND	129	131
" CLAY	131	135
" SAND	135	157

DRILLERS REMARKS:

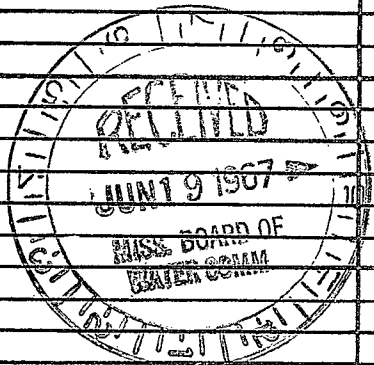

If well telescopes please sketch and show depths.

GROUND LEVEL

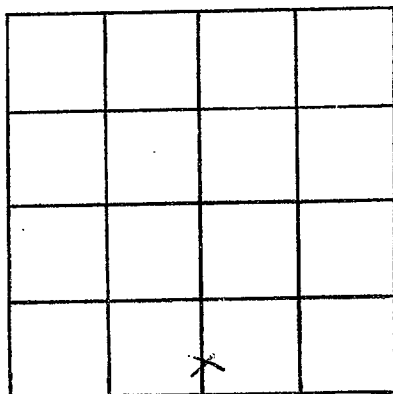

SECTION \_\_\_\_\_

Please indicate well location X.

ADDITIONAL INFORMATION

If more than one screen, show locations of each on sketch.