

Lowndes
C 203
4-21-76

MISSISSIPPI
 BOARD OF WATER COMMISSIONERS
 416 North State Street
 Jackson, Mississippi 39201

WATER WELL DRILLERS LOG

4-21 1976 Mid South Drilling Co. Lowndes
 date well completed firm name county well located

LANDOWNER: Tommy Viree
Columbus Miss.
 (mailing address)
 WELL LOCATION:
 sec. 15 T. 17 N. R. 18 E.
1 miles N of Columbus
 (distance) (direction) (nearest town)

description of formations encountered	from	to
<u>Brown clay</u>	<u>0</u>	<u>13</u>
<u>blue clay & sand streaks</u>	<u>13</u>	<u>274</u>
<u>Sand</u>	<u>274</u>	<u>315</u>

WELL PURPOSE:
 (home, irrigation, municipal, industrial)


WELL COMPLETION DATA:
 (1) diameter (inches) 4"
 (2) total depth (feet) 315'
 (3) static water level (feet) 60 below/above top of ground.
 (4) casing PVC 124'
 (material) (depth)
 (size) if telescope see back.
 (5) screen _____
 (length) (depth to top)
 (size) (material)
 (6) pump 1/2 12
 (HP) (yield gpm)
elec
 (type power)
 (7) electric log no
 (yes or no)
 (organization running log)
 (8) how well bottom plugged 0

NOV 15 1976
 MISS. BD. OF WATER COMMISSIONERS

DRILLERS REMARKS:

If well telescopes please sketch and show depths.

GROUND LEVEL

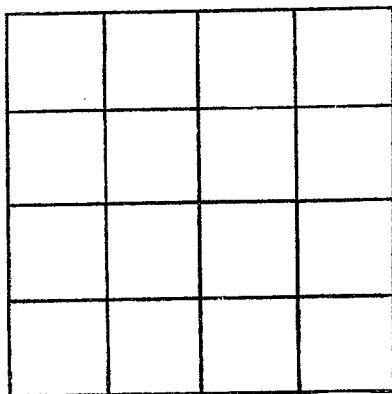

SECTION _____

Please indicate well location X.

ADDITIONAL INFORMATION

well is on
Blue Cut Road
at House of
Light in
North Columbus
Mississippi

If more than one screen,
show locations of each on sketch.