

LOWNDS
 C 2007
 9-21-76

MISSISSIPPI
 BOARD OF WATER COMMISSIONERS
 416 North State Street
 136 Jackson, Mississippi 39201

WATER WELL DRILLERS LOG

9-21 date well completed
 136 Mid South Drilling firm name
 Lownds county well located

LANDOWNER: M. M. Jenkins

description of formations encountered	from	to
Clay	0	15
Sand & Gravel	15	32
Shale	32	98
Blue Shale & Sand	90	210

Highway 45 N.
 Columbus, MS.
 (mailing address)

WELL LOCATION:
 sec. 20 T. 17 N. R. 18 E.
 4 miles N. of Columbus
 (distance) (direction) (nearest town)

WELL PURPOSE: Home
 (home, irrigation, municipal, industrial)

WELL COMPLETION DATA:

- (1) diameter (inches) 4"
- (2) total depth (feet) 210
- (3) static water level (feet) 35 below top of ground.
- (4) casing pvc, 80 (material), (depth)
 (size) if telescope see back.
- (5) screen (length), (depth to top)
 (size) (material)
- (6) pump 1/2 (HP), 0 (yield gpm)
 Elect (type power)
- (7) electric log (yes or no)
 (organization running log)
- (8) how well bottom plugged (P)


RECEIVED
 NOV 15 1976

MISS. BD. OF WATER COMMISSIONERS

DRILLERS REMARKS:

If well telescopes please sketch and show depths.

GROUND LEVEL

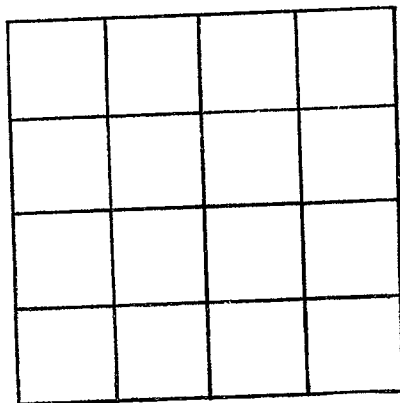

SECTION _____

Please indicate well location X.

ADDITIONAL INFORMATION

If more than one screen,
show locations of each on sketch.