

LOWNDES
C 2008
2-17-77

MISSISSIPPI
 BOARD OF WATER COMMISSIONERS
 416 North State Street
 132 Jackson, Mississippi 39201

1st Well of 1977

WATER WELL DRILLERS LOG

Lowndes
 DeWitt

Feb. 17 1977 date well completed
 Allam Shellmoe firm name
 DeWitt county well located

Mr. W. W. Johnson
 LANDOWNER
 Stone & Graham Bldg
 Columbus, Miss
 (mailing address)

description of formations encountered	from	to
Clay Top	0	8
Red Sand Formation	8	43
Goth Rock	4	inches
Mud	43	45
Blue Water Sand	45	288

WELL LOCATION:
 sec. 32 T. 17 N. R. 18 E.
 3/4 miles S W of Columbus
 (distance) (direction) (nearest town)

WELL PURPOSE: home
 (home, irrigation, municipal, industrial)

WELL COMPLETION DATA:
 (1) diameter (inches) 4" x 2"
 (2) total depth (feet) 288'
 (3) static water level (feet) 112 below top of ground.
 (4) casing 1" Plastic, 136 (material) (depth)
 4" x 2" (size) if telescope see back.
 (5) screen 70' 176' (length) (depth to top)
 No 10-2" Plastic (size) (material)
 (6) pump 1/2 14 (HP) (yield gpm)
 Electric (type power)
 (7) electric log No - (yes or no)
 (organization running log)
 (8) how well bottom plugged CAT

RECEIVED
 FEB 22 1977

DRILLERS REMARKS:

MISS. BD. OF WATER COMMISSIONERS


If well telescopes please sketch and show depths.

GROUND LEVEL

4" casing
136

2" casing
84'

70' 2"
Blow

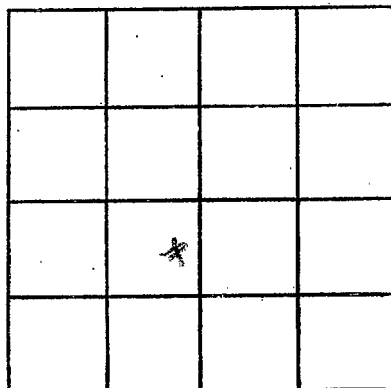

SECTION 32

Please indicate well location X.

ADDITIONAL INFORMATION

If more than one screen, show locations of each on sketch.