

**LOWNDES**  
 C 2010  
 2-8-77

MISSISSIPPI  
 BOARD OF WATER COMMISSIONERS  
 416 North State Street  
 Jackson, Mississippi 39201

13L

WATER WELL DRILLERS LOG

2-8 date well completed      1977 MIDSOUTH DRILLING firm name      LOWNDES county well located

LANDOWNER: AB. Shetter Jr.  
air base, road  
Columbus, MS.  
 (mailing address)

description of formations encountered	from	to
<del>sd</del> Sand & Gravel	0	18
blue shale	18	141
sand	141	147
blue shale	147	165
sand	165	180

WELL LOCATION:  
 sec. 17 T. 17 N. R. 18 W.  
5 mi miles N. of Columbus  
 (distance) (direction) (nearest town)

WELL PURPOSE: trailer park  
 (home, irrigation, municipal, industrial)

- WELL COMPLETION DATA:
- (1) diameter (inches) 4"
  - (2) total depth (feet) 180
  - (3) static water level (feet) 30 below top of ground.
  - (4) casing PVC, 80 (material), (depth)  
4" (size) if telescope see back.
  - (5) screen none (length), (depth to top)  
 (size), (material)
  - (6) pump none (HP), none (yield gpm)  
all installed pump (type power)
  - (7) electric log \_\_\_\_\_ (yes or no)  
 \_\_\_\_\_ (organization running log)
  - (8) how well bottom plugged \_\_\_\_\_


**RECEIVED**  
 JUN 23 1977

MISS. Bd. OF WATER COMMISSIONERS

DRILLERS REMARKS: \_\_\_\_\_

If well telescopes please  
sketch and show depths.

GROUND LEVEL

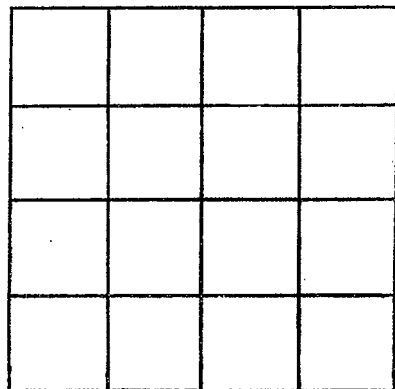

SECTION \_\_\_\_\_

Please indicate well location X.

ADDITIONAL INFORMATION

If more than one screen,  
show locations of each on sketch.