

Louder
C 2011
7/20/77

MISSISSIPPI
 BOARD OF WATER COMMISSIONERS
 416 North State Street
 13L Jackson, Mississippi 39201

WATER WELL DRILLERS LOG


July 20 1977 Mid South Drilling Co Louder
 date well completed firm name county well located

LANDOWNER: <u>Don Callaway</u>	description of formations encountered	from	to
<u>Columbus, MS</u> (mailing address)			
WELL LOCATION: sec <u>29</u> T <u>17</u> N R <u>18</u> E miles <u>North</u> of <u>Columbus</u> (distance) (direction) (nearest town)	<u>Yellow clay</u>	<u>0</u>	<u>37</u>
WELL PURPOSE: <u>Home</u> (home, irrigation, municipal, industrial)	<u>blue shale</u>	<u>37</u>	<u>136</u>
WELL COMPLETION DATA: (1) diameter (inches) <u>4"</u> (2) total depth (feet) <u>285</u> (3) static water level (feet) <u>120</u> below above top of ground. (4) casing <u>PVC</u> , <u>110</u> , (material) (depth) If telescope see back. (size) (5) screen <u>1/2" x 1/2"</u> (length) (depth to top) (size) (material) (6) pump <u>3/4</u> <u>10</u> (HP) (yield gpm) (type power) (7) electric log <u>NONE</u> (yes or no) (organization running log) (8) how well bottom plugged <u>OPEN</u>	<u>Sand</u>	<u>136</u>	<u>145</u>
	<u>Blue Shale & Sand</u>	<u>145</u>	<u>250</u>
	<u>Sand & clay shales</u>	<u>254</u>	<u>270</u>
	<u>Blue shale</u>	<u>270</u>	<u>285</u>
DRILLERS REMARKS:			

RECEIVED
 SEP 11 1977
 MISS. Bd. OF WATER COMMISSIONERS

If well telescopes please sketch and show depths.

GROUND LEVEL

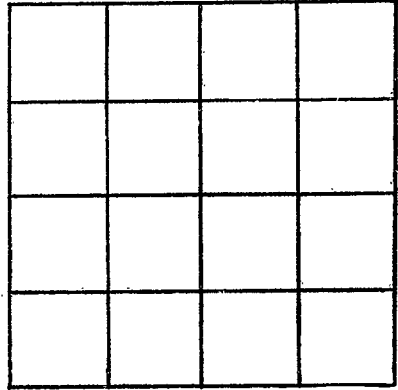

SECTION _____

Please indicate well location X.

ADDITIONAL INFORMATION

If more than one screen, show locations of each on sketch.