

LOWDES

C 2012

8-25-78

MISSISSIPPI
 BOARD OF WATER COMMISSIONERS
 416 North State Street
 Jackson, Mississippi 39201

WATER WELL DRILLERS LOG

August 25 1978 Mid-South Drlg. Co. Lowdes
 date well completed firm name county well located


LANDOWNER: <u>Danny Watson</u>	description of formations encountered	from	to
<u>Rt. 5 Box 113</u>			
<u>Columbus, MS 39701</u> (mailing address)	<u>sand & gravel</u>	<u>7</u>	<u>55</u>
WELL LOCATION:	<u>clay</u>	<u>55</u>	<u>60</u>
<u>sec. 24 T 17 S R 18</u>	<u>clay & sand</u>	<u>60</u>	<u>105</u>
<u>4</u> miles <u>North</u> of <u>Col.</u>	<u>clay</u>	<u>105</u>	<u>130</u>
(distance) (direction) (nearest town)	<u>sand</u>	<u>130</u>	<u>137</u>
WELL PURPOSE: <u>home</u> (home, irrigation, municipal, industrial)			
WELL COMPLETION DATA:			
(1) diameter (inches) <u>4</u>			
(2) total depth (feet) <u>137</u>			
(3) static water level (feet) <u>4</u> below top of ground.			
(4) casing <u>PVC</u> , <u>107</u> (material) (depth) (size) if telescope see back.			
(5) screen <u>none</u> , (length) (depth to top) (size) (material)			
(6) pump <u>1/2</u> , <u>12</u> (HP) (yield gpm) <u>electric</u> (type power)			
(7) electric log <u>no</u> (yes or no) (organization running log)			
(8) how well bottom plugged <u>open</u>			
DRILLERS REMARKS:			

RECEIVED
 SEP - 5 1978

MISS. BD. OF WATER COMMISSIONERS

If well telescopes please sketch and show depths.

GROUND LEVEL

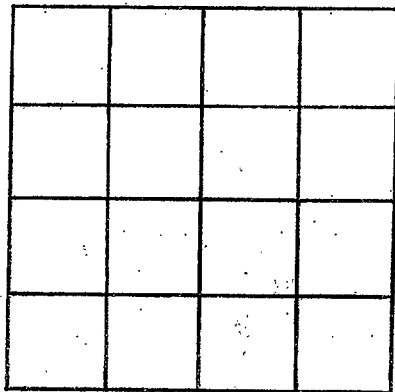

SECTION _____

Please indicate well location X.

ADDITIONAL INFORMATION

If more than one screen,
show locations of each on sketch.