

LOWNDES
 C 2013
 12-22-78

MISSISSIPPI
 BOARD OF WATER COMMISSIONERS
 416 North State Street
 Jackson, Mississippi 39201

WATER WELL DRILLERS LOG

12/22 1978 ALL SUP DRILLING INC Lowndes
 date well completed firm name county well located

LANDOWNER: Airline
 Manufacturing Co.
 P.O. Box 2268
 Columbus, MS. 39701
 (mailing address)

description of formations encountered	from	to
Top Soil	0	8
Gravel + SAND	8	40
Blue Rock	40	140
SAND	140	357

WELL LOCATION:
 sec 24 T 17 N R 17 E
 S S
 3 miles NW of Columbus
 (distance) (direction) (nearest town)

WELL PURPOSE: home
 (home, irrigation, municipal, industrial)

WELL COMPLETION DATA:

(1) diameter (inches) 4" X 2"
 (2) total depth (feet) 357'
 (3) static water level (feet) 22' below
 top of ground. above
 (4) casing 4" plastic, 140'
 (material) (depth)
 4" X 2" if telescope see back.
 (size)
 (5) screen 80' 277'
 (length) (depth to top)
 4" X 2" plastic
 (size) (material)
 (6) pump 2 20
 (HP) (yield gpm)
 Electric
 (type power)
 (7) electric log NO
 (yes or no)
 (organization running log)
 (8) how well bottom plugged CAP

Miss. Board of Water Comm.

APR 10 1979


RECEIVED

DRILLERS REMARKS:

If well telescopes please sketch and show depths.

GROUND LEVEL

4" 140'
Casing

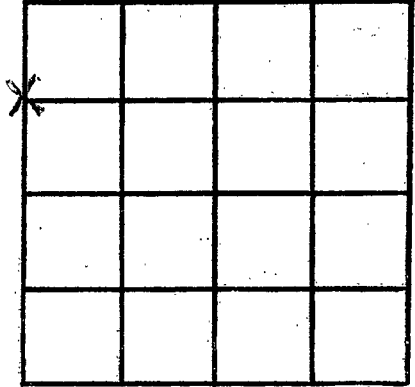

SECTION 24

Please indicate well location X.

ADDITIONAL INFORMATION

125'
2" casing
100'
2"
Commercial
Screen

If more than one screen,
show locations of each on sketch.