

LOWNDES

C 2514

3-28-79

MISSISSIPPI BOARD OF WATER COMMISSIONERS
416 North State Street
Jackson, Mississippi 39201

WATER WELL DRILLERS LOG

March 16 1979
date well completed

79 Mid. South Drilling
firm name

Loundes
county well located

LANDOWNER: <u>Don Conberg</u>	description of formations encountered	from	to
<u>Columbus MS 39701</u> (mailing address)	<u>sand + clay</u>	<u>0</u>	<u>80</u>
WELL LOCATION: sec <u>21</u> T <u>17</u> R <u>18</u> <u>2</u> miles <u>N</u> of <u>Col</u> (distance) (direction) (nearest town)	<u>clay</u>	<u>80</u>	<u>135</u>
	<u>clay + sand</u>	<u>135</u>	<u>159</u>
	<u>rock</u>	<u>160</u>	<u>162</u>
WELL PURPOSE: <u>home</u> (home, irrigation, municipal, industrial)	<u>clay + sand</u>	<u>162</u>	<u>300</u>
WELL COMPLETION DATA: (1) diameter (inches) <u>4"</u>	<u>sand + clay</u>	<u>300</u>	<u>355</u>
(2) total depth (feet) <u>355</u>			
(3) static water level (feet) <u>80</u> ^{below} above top of ground.			
(4) casing <u>PVC</u> <u>170</u> (material) (depth)			
<u>4</u> (size) if telescope see back.			
(5) screen <u>no</u> (length) (depth to top)			
(size) (material)			
(6) pump <u>3/4</u> <u>10</u> (HP) (yield gpm)			
<u>electric</u> (type power)			
(7) electric log <u>no</u> (yes or no)			
<u>no</u> (organization running log)			
(8) how well bottom plugged <u>open</u>			
DRILLERS REMARKS:			


Miss. Board of Water Comm.

MAR 27 1979

RECEIVED

If well telescopes please sketch and show depths.

GROUND LEVEL

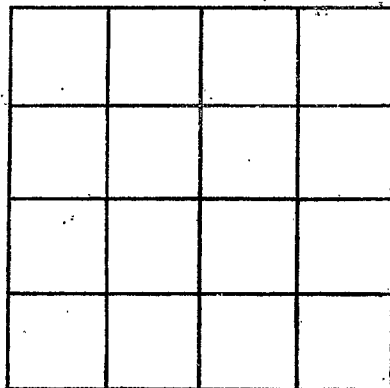

SECTION _____

Please indicate well location X.

ADDITIONAL INFORMATION

If more than one screen,
show locations of each on sketch.