

LOWNDES
C 2015
4-6-79

MISSISSIPPI
 BOARD OF WATER COMMISSIONERS
 416 North State Street
 Jackson, Mississippi 39201

WATER WELL DRILLERS LOG

April 6 1979 Mid South Drilling Co. Lowndes
 date well completed firm name county well located

LANDOWNER <u>Mr. Glenn</u>	description of formations encountered	from	to
<u>Columbus MS 39701</u> (mailing address)	<u>clay + sand</u>	<u>0</u>	<u>30</u>
	<u>rock</u>	<u>30</u>	<u>45</u>
WELL LOCATION: sec <u>29</u> T <u>17</u> S R <u>12</u> E <u>1 1/2</u> miles <u>NW</u> of <u>Col.</u> (distance) (direction) (nearest town)	<u>clay</u>	<u>45</u>	<u>195</u>
	<u>clay + sand</u>	<u>195</u>	<u>255</u>
WELL PURPOSE: <u>None</u> (home, irrigation, municipal, industrial)	<u>clay</u>	<u>255</u>	<u>270</u>
WELL COMPLETION DATA: (1) diameter (inches) <u>4</u> (2) total depth (feet) <u>360</u> (3) static water level (feet) <u>40</u> below top of ground. (4) casing <u>PVC</u> , <u>150</u> (material) (depth) <u>4</u> (size) If telescope see back. (5) screen <u>None</u> (length) (depth to top) (size) (material) (6) pump <u>3/4</u> <u>10</u> (HP) (yield gpm) <u>electric</u> (type power) (7) electric log <u>no</u> (yes or no) <u>no</u> (organization running log) (8) how well bottom plugged _____	<u>sand + clay</u>	<u>270</u>	<u>360</u>
DRILLERS REMARKS:			


Miss. Board of Water Comm.

MAY 29 1979

FRANK

If well telescopes please sketch and show depths.

GROUND LEVEL

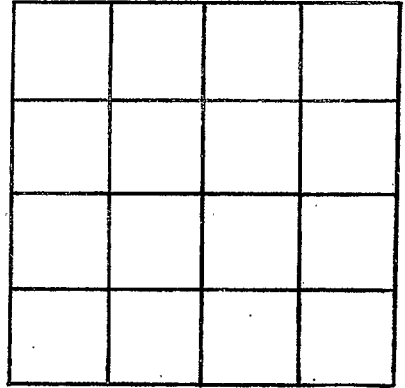

SECTION _____

Please indicate well location X.

ADDITIONAL INFORMATION

If more than one screen,
show locations of each on sketch.