

LOWNDES
C 2017
5-3-79

MISSISSIPPI
 BOARD OF WATER COMMISSIONERS
 416 North State Street
 Jackson, Mississippi 39201

WATER WELL DRILLERS LOG


May 3 79 Mid South Drilling Co. Lowndes
 date well completed firm name county well located

LANDOWNER:	description of formations encountered	from	to
<u>Mr. Boland</u> <u>Star Route Box 216</u> <u>Columbus MS 39701</u> (mailing address)			
WELL LOCATION:	<u>sand & gravel</u>	<u>8</u>	<u>15</u>
sec. <u>3</u> T. <u>17</u> S. R. <u>18</u> E. W.	<u>sand</u>	<u>15</u>	<u>27</u>
<u>5</u> miles <u>N</u> of <u>Columbus</u>	<u>clay</u>	<u>27</u>	<u>30</u>
(distance) (direction) (nearest town)	<u>clay & sand</u>	<u>30</u>	<u>126</u>
WELL PURPOSE: <u>Home</u> (home, irrigation, municipal, industrial)	<u>clay</u>	<u>126</u>	<u>135</u>
WELL COMPLETION DATA:			
(1) diameter (inches) <u>4</u>			
(2) total depth (feet) <u>135</u>			
(3) static water level (feet) <u>7</u> below top of ground.			
(4) casing <u>PVC</u> <u>25</u> (material) (depth)			
<u>4</u> (size) if telescope see back.			
(5) screen <u>NO</u> (length) (depth to top)			
(size) (material)			
(6) pump <u>1/2</u> <u>10</u> (HP) (yield gpm)			
<u>electric</u> (type power)			
(7) electric log <u>NO</u> (yes or no)			
<u>NO</u> (organization running log)			
(8) how well bottom plugged <u>open</u>			
DRILLERS REMARKS:			

MISS. BOARD OF WATER COMM.
 JUN 25 1979
RECEIVED

If well telescopes please sketch and show depths.

GROUND LEVEL

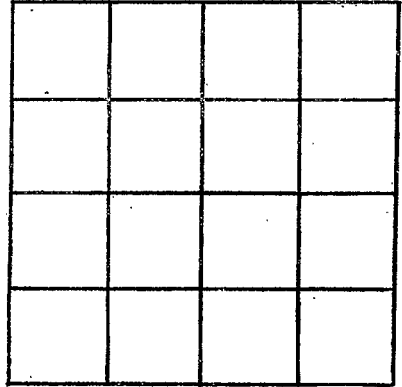

SECTION _____

Please indicate well location X.

ADDITIONAL INFORMATION

If more than one screen, show locations of each on sketch.