

Lowndes  
C 2019  
11-27-79

MISSISSIPPI  
 BOARD OF WATER COMMISSIONERS  
 416 North State Street  
 Jackson, Mississippi 39201

WATER WELL DRILLERS LOG

11-27 date well completed      1979 Midlands Drilling Lowndes firm name      county well located

LANDOWNER: Mr. Edmonson  
924 Air Base Road  
Columbus MS 39701  
 (mailing address)

description of formations encountered	from	to
clay	0	8
sand & gravel	8	27

WELL LOCATION:  
 sec 27 T 17 S R 18 W  
3 miles N of Columbus  
 (distance) (direction) (nearest town)

description of formations encountered	from	to
clay	27	100
clay & sand	100	180

WELL PURPOSE: home  
 (home, irrigation, municipal, industrial)

WELL COMPLETION DATA:

- (1) diameter (inches) 4"
- (2) total depth (feet) 180
- (3) static water level (feet) 40 below top of ground.
- (4) casing PVC 90 (material), (depth)  
4" (size) if telescope see back.
- (5) screen N/A (length), (depth to top)  
 (size) (material)
- (6) pump 1/2 (HP), 5 (yield gpm)  
electric (type power)
- (7) electric log no (yes or no)  
no (organization running log)
- (8) how well bottom plugged: Open

DEPT. OF NATURAL RESOURCES  
 BUREAU OF LAND & WATER RESOURCES


JAN 7 1980

RECEIVED

DRILLERS REMARKS:

If well telescopes please sketch and show depths.

GROUND LEVEL

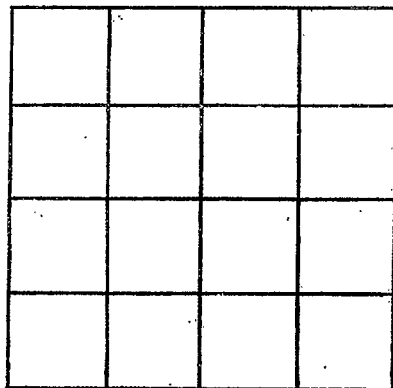

SECTION \_\_\_\_\_

Please indicate well location X.

ADDITIONAL INFORMATION

If more than one screen,  
show locations of each on sketch.