

Lowndes

C 2021

5/7/80

MISSISSIPPI
 BOARD OF WATER COMMISSIONERS
 416 North State Street
 Jackson, Mississippi 39201

WATER WELL DRILLERS LOG

May 7, 1980 19 Mid South Drilling Co. Lowndes
 date well completed firm name county well located

LANDOWNER: Bill Stevenson
Rt. 1 Box 346
Smithville, MS
 (mailing address)

description of formations encountered	from	to
sand	0	12
clay	12	135
clay and sand	135	160
clay	160	165
clay and sand	165	315

WELL LOCATION:
 sec. 29 T 17 S R. 18 W
1 miles N of Col.
 (distance) (direction) (nearest town)

WELL PURPOSE: home
 (home, irrigation, municipal, industrial)


- WELL COMPLETION DATA:
- (1) diameter (inches) 4
 - (2) total depth (feet) 315
 - (3) static water level (feet) 120 below top of ground. ~~36200~~
 - (4) casing PVC, 160
 (material) (depth)
4"
 (size) if telescope see back.
 - (5) screen n/a,
 (length) (depth to top)
n/a
 (size) (material)
 - (6) pump 1 10
 (HP) (yield gpm)
electric
 (type power)
 - (7) electric log no
 (yes or no)
no
 (organization running log)
 - (8) how well bottom plugged open

DRILLERS REMARKS:

DEPT. OF NATURAL RESOURCES
 BUREAU OF LAND & WATER RESOURCES
 MAY 14 1980
 RECEIVED

If well telescopes please sketch and show depths.

GROUND LEVEL

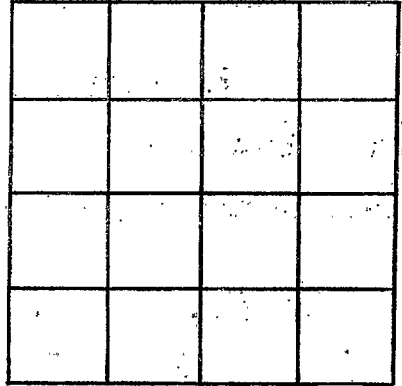

SECTION _____

Please indicate well location X.

ADDITIONAL INFORMATION

If more than one screen,
show locations of each on sketch.