

MISSISSIPPI DEPARTMENT OF NATURAL RESOURCES

Bureau of Land and Water Resources

Southport Mall

P.O. Box 10631

Jackson, Mississippi 39209

WATER WELL DRILLERS LOG

LOWNDES
C 2022
7-18-80

July 18 1980 Clardy Well Drilling Lowndes
 date well completed firm name county well located

LANDOWNER: L. C. Underwood
Rt. 1 Box 375
Stens, Miss. 39766
 (mailing address)

WELL LOCATION:
 sec. 12 T. 17 N. R. 18 E.
6 miles SW of Caledonia
 (distance) (direction) (nearest town)

WELL PURPOSE:
 (home, irrigation, municipal, industrial)

WELL COMPLETION DATA:

- (1) diameter (inches) 4"
- (2) total depth (feet) 195'
- (3) static water level (feet) 33 below above-top of ground.
- (4) casing PVC 110'
 (material) (depth)
 if telescope see back.
 (size)
- (5) screen
 (length) (depth to top)
 (size) (material)
- (6) pump 1/2 12
 (HP) (yield gpm)
 (type power)
- (7) electric log no
 (yes or no)
 (organization running log)
- (8) how well bottom plugged


description of formations encountered	from	to
red. Clay	0	8
Clay & gravel - Sand & gravel	8	38
Soft white. Clay	38	65
Soft blue. Clay	65	90
blue. Clay	90	115
Sandy Clay	115	130
blue. Clay	130	170
Sand	170	195

DRILLERS REMARKS:

DEPT. OF NATURAL RESOURCES
 BUREAU OF LAND & WATER RESOURCES
 AUG 12 1980
 RECEIVED

If well telescopes please sketch and show depths.

GROUND LEVEL

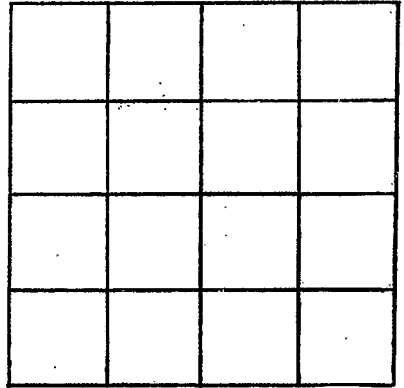

SECTION _____

Please indicate well location X.

ADDITIONAL INFORMATION

If more than one screen,
show locations of each on sketch.