

LOWMEDES
C 2023

MISSISSIPPI
BOARD OF WATER COMMISSIONERS
416 North State Street
Jackson, Mississippi 39201

2-28-80

WATER WELL DRILLERS LOG

Feb. 28 19 80

Marvin & R. [unclear]

Lowmedes Co Miss

date well completed

firm name

county well located

LANDOWNER: James Miller
Columbus Air Base
Columbus Miss.
(mailing address)

description of formations encountered

from

to

clay	0	8
Dravel	8	21
Blue Clay	21	80
Blue Clay		
& Sand Strata	80	180

WELL LOCATION:

sec. 5 T. 17 N. R. 18 E
1/2 mi East of State #1 W of CAFB
(distance) (direction) (nearest town)

WELL PURPOSE:

HOME
(home, irrigation, municipal, industrial)

WELL COMPLETION DATA:

- (1) diameter (inches) 4"
- (2) total depth (feet) 180'
- (3) static water level (feet) 25' below top of ground.
- (4) casing PVC, 100' (material) (depth)
4" (size) If telescope see back.
- (5) screen (length) (depth to top)
(size) (material)
- (6) pump 1/2 12 (HP) (yield gpm)
C. (type power)
- (7) electric log no (yes or no)

(organization running log)

(8) how well bottom plugged open

DRILLERS REMARKS:


DEPT. OF NATURAL RESOURCES
BUREAU OF LAND & WATER RESOURCES

APR 16 1980

RECEIVED

If well telescopes please sketch and show depths.

GROUND LEVEL

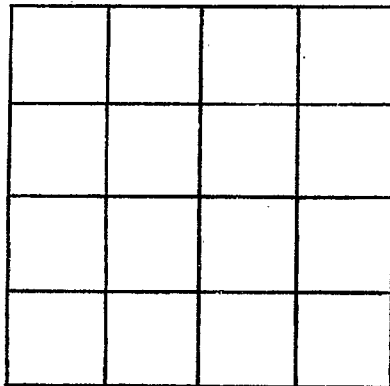

SECTION _____

Please indicate well location X.

ADDITIONAL INFORMATION

If more than one screen, show locations of each on sketch.